

MISSISSIPPI DEPARTMENT OF NATURAL RESOURCES

Bureau of Land and Water Resources

Southport Mall

P.O. Box 10631

Jackson, Mississippi 39209

WATER WELL DRILLERS LOG

Harrison
L 2122

9-14-87 19__
date well completed

R. V. Meake
firm name

HARRISON
county well located

LANDOWNER: Naomi Herren
~~HARMOKE HEKELIN~~
3 km RD
Quitman ms
(mailing address)

WELL LOCATION:
sec. 10 T. 7 N. R. 11 E
7 miles N of Quitman
(distance) (direction) (nearest town)

description of formations encountered	from	to
<u>TOP SLT & CLG</u>	<u>0</u>	<u>20</u>
<u>CLAY SLT & GPH</u>	<u>20</u>	<u>75</u>
<u>SLT & BLUE CLAY</u>	<u>70</u>	<u>100</u>
<u>BLUE CLAY</u>	<u>100</u>	<u>500</u>
<u>CLAY SLT & GPH</u>	<u>500</u>	<u>560</u>

WELL PURPOSE:
(home, irrigation, municipal, industrial)

WELL COMPLETION DATA:

(1) diameter (inches) 2"

(2) total depth (feet) 560'

(3) static water level (feet) 50' ^{below} _{above} top of ground.

(4) casing Pvc, 560'
(material) (depth)
 if telescope see back.
(size)

(5) screen 10', 560'
(length) (depth to top)
2", Pvc
(size) (material)

(6) pump 1 (HP) 6 (yield gpm)
E
(type power)

(7) electric log
(yes or no)

(organization running log)

(8) how well bottom plugged

RECEIVED

NOV 04 1987

Department of Natural Resources
Bureau of Land & Water Resources

DRILLERS REMARKS:


If well telescopes please sketch and show depths.

GROUND LEVEL

MOCKE

250
200
150
100
50
0

24 ft 10 in
24 ft 2 in
24 ft 10 in
24 ft 2 in
24 ft 10 in
24 ft 2 in
24 ft 10 in
24 ft 2 in

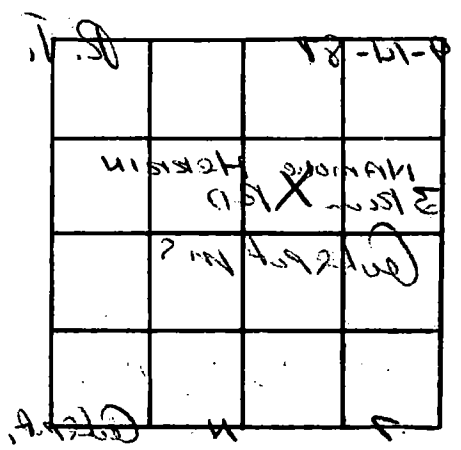

SECTION 18

Please indicate well location X.

ADDITIONAL INFORMATION

250

200

150

100

50

0

CONCRETE

CONCRETE

If more than one screen, show locations of each on sketch.