

MISSISSIPPI DEPARTMENT OF NATURAL RESOURCES
Bureau of Land and Water Resources

P.O. Box 10631
Jackson, Mississippi 39209
WATER WELL DRILLERS LOG

COUNTY WELL LOCATED Harrison		PERMIT NUMBER
WELL NUMBER L 2123	CODED	NAME OF DRILLING FIRM
DATE WELL COMPLETED 7-24-87		Mt B Drilling Co.

NAME & MAILING ADDRESS OF LANDOWNER
Lampley Oil Co.
P.O. Box 6251
Culfport, Miss. 39506

WELL LOCATION: SEC **5** TOWNSHIP **7** RANGE **11** **W**

DISTANCE **2** Miles DIRECTION **N** of NEAREST TOWN **London**

OTHER LANDMARK

WELL PURPOSE: Home, Irrigation, Municipal, Industrial, Fish Pond, etc.
Sprinkler System - Lawn

PUMP DATA

PUMP TYPE (Circle One):
Submersible, Turbine, Jet, Flowing Well,
Other (Describe) _____

POWER TYPE (Circle One):
Electric, Tractor, Diesel, Gasoline, Butane,
Other (Describe) **SHP**

Pump Capacity (GPM) **70** No. of Stages _____ Setting Depth **120** FT.

PUMP TEST
Well yielded **70** GPM with
a drawdown of _____ ft.
after _____ hours of pumping

WELL DATA

Well Depth 560	Casing Diameter (In.) 4"	Casing Length (Ft.) 540
Type of Casing PRC	Hole Depth 560	Depth to Static Water Level 60

TYPE OF COMPLETION: (Circle One or More):
Natural Development, Gravel Packed, Underreamed, Telescoped,
Open Hole, Other

Top of Lap Pipe or Reduction in Casing

FEET IF TELESCOPED OR MORE THAN ONE SCREEN: USE BACK PAGE

LOG DATA

TYPE OF LOG RUN (Circle One):
Electric, Gamma Ray, Density, Sonic, No Log Run, Neutron,
Other (Describe) _____

Name of Organization Running Log

SCREEN DATA

Diameter - Inches 4"	Length - Feet 20 FT	Slot Size - Inches .010
Screen Type PRC-WOP	Depth to Bottom - Feet 560	

GEOLOGIC DATA (Office Use Only)

Surface Elev.	Geologic Unit	Unit Thickness	Depth to Top
Subs. SWL	Date	Analysis	Aquifer Test

Driller's Remarks


RECEIVED

DESCRIPTION OF FORMATIONS ENCOUNTERED	FROM	TO	FORMATIONS (Continued)	FROM	TO
Surface	0	6	Department of Natural Resources Bureau of Land & Water Resources		
Clay	6	80			
Gray Sand	80	100			
Sand & Clay	100	160			
Clay	160	280			
Clay Break - sand	280	300			
Clay	300	400			
Clay - Sand	400	420			
Sand - clay Break	420	440			
Clay	440	500			
Sand	500	560			

IF MORE SPACE IS NEEDED, USE BACK

If well telescopes please sketch and show depths.

GROUND LEVEL

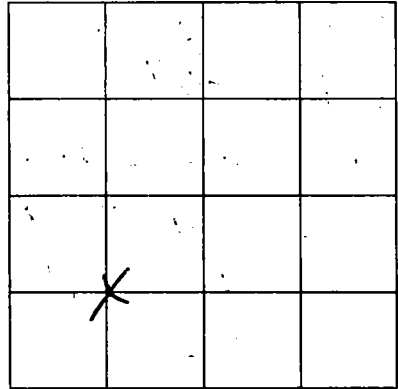

SECTION 5

Please indicate well location X.

ADDITIONAL INFORMATION

If more than one screen,
show location of each on sketch.