

MISSISSIPPI DEPARTMENT OF NATURAL RESOURCES
Bureau of Land and Water Resources

P.O. Box 10631

Jackson, Mississippi 39209

WATER WELL DRILLERS LOG

COUNTY WELL LOCATED <i>Harrison</i>	
WELL NUMBER <i>L 2128</i>	CODE <i>2</i>
DATE WELL COMPLETED <i>1-15-88</i>	

PERMIT NUMBER
NAME OF DRILLING FIRM <i>Mark Drilling Co.</i>

NAME & MAILING ADDRESS OF LANDOWNER <i>Lawlers #1</i>			
<i>A. way 49 N.</i>			
<i>Suffport, Miss.</i>			
WELL LOCATION:	SEC <i>32</i>	TOWNSHIP <i>7 S</i>	RANGE <i>11 E W</i>
DISTANCE <i>2</i> Miles	DIRECTION <i>S</i>	NEAREST TOWN <i>Lyman</i>	
OTHER LANDMARK			
WELL PURPOSE: Home, Irrigation, Municipal, Industrial, Fish Pond, etc. <i>Store</i>			

PUMP DATA		
PUMP TYPE (Circle One): Submersible, Turbine, <input checked="" type="radio"/> Jet, Flowing Well, Other (Describe) _____		
POWER TYPE (Circle One): <input checked="" type="radio"/> Electric, Tractor, Diesel, Gasoline, Butane, Other (Describe) _____		
Pump Capacity (GPM) <i>10</i>	No. of Stages <i>2</i>	Setting Depth FT.
PUMP TEST		
Well yielded <i>10</i> GPM with a drawdown of _____ ft. after _____ hours of pumping		

WELL DATA		
Well Depth <i>440</i>	Casing Diameter (In.) <i>2"</i>	Casing Length (Ft.) <i>430</i>
Type of Casing <i>PVC</i>	Hole Depth <i>440</i>	Depth to Static Water Level <i>80 FT</i>
TYPE OF COMPLETION: (Circle One or More): <input checked="" type="radio"/> Gravel Pack, <input type="radio"/> Underreamed, <input type="radio"/> Telescoped, (Natural Development), <input type="radio"/> Open Hole, <input type="radio"/> Other (Describe) _____		
Top of Lap Pipe or Reduction in Casing FEET <input type="checkbox"/> IF TELESKOPED OR MORE THAN ONE SCREEN: USE BACK PAGE		

LOG DATA	
TYPE OF LOG RUN (Circle One): Electric, Gamma Ray, Density, Sonic, <input checked="" type="radio"/> Neutron, Other (Describe) _____	
Name of Organization Running Log	

SCREEN DATA		
Diameter - Inches <i>2"</i>	Length - Feet <i>10</i>	Slot Size - Inches <i>.008</i>
Screen Type <i>PVC WOP</i>	Depth to Bottom - Feet <i>430</i>	

GEOLOGIC DATA (Office Use Only)			
Surface Elev.	Geologic Unit	Unit Thickness	Depth to Top
Subs. SWL	Date	Analysis	Aquifer Test
Driller's Remarks <i>10 FT - 2" Telescoped</i>			

DESCRIPTION OF FORMATIONS ENCOUNTERED	FROM	TO	FORMATIONS (Continued)	FROM	TO
<i>Surface</i>	<i>0</i>	<i>20</i>			
<i>Sand (White)</i>	<i>20</i>	<i>35</i>			
<i>Block Clay</i>	<i>35</i>	<i>100</i>			
<i>Sand</i>	<i>100</i>	<i>220</i>			
<i>Blue Clay</i>	<i>220</i>	<i>360</i>			
<i>Sand + Clay Breeds</i>	<i>360</i>	<i>370</i>			
<i>Gray Sand</i>	<i>370</i>	<i>435</i>			
<i>Blue Clay</i>	<i>435</i>	<i>440</i>	<i>+</i>		


RECEIVED
FEB 22 1988

Department of Natural Resources
Bureau of Land & Water Resources

IF MORE SPACE IS NEEDED, USE BACK

If well telescopes please sketch and show depths.

GROUND LEVEL

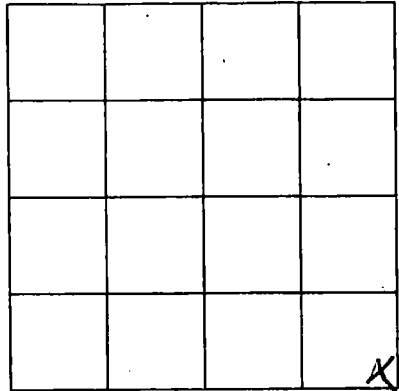

SECTION 32

Please indicate well location X.

ADDITIONAL INFORMATION

If more than one screen,
show location of each on sketch.