

**MISSISSIPPI DEPARTMENT OF NATURAL RESOURCES**  
Bureau of Land and Water Resources

P.O. Box 10631

Jackson, Mississippi 39209

**WATER WELL DRILLERS LOG**

COUNTY WELL LOCATED <b>HARRISON</b>	
WELL NUMBER <b>2136</b>	CODED
DATE WELL COMPLETED <b>NOV. 25 - 88</b>	

PERMIT NUMBER <b>0-239</b>
NAME OF DRILLING FIRM <b>McGill Pump &amp; Wells</b>

NAME & MAILING ADDRESS OF LANDOWNER <b>HARRY Bowman</b>		
<b>116092 Garden Rd.</b>		
<b>GPT. MS.</b>		
WELL LOCATION: SEC	TOWNSHIP	RANGE
<b>17</b>	<b>7</b>	<b>11</b>
	N	E
	S	W
DISTANCE	DIRECTION	NEAREST TOWN
<b>2</b> Miles	<b>West</b> of	<b>49</b>
OTHER LANDMARK <b>GPT.</b>		
WELL PURPOSE: Home, Irrigation, Municipal, Industrial, Fish Pond, etc. <b>Home</b>		

<b>PUMP DATA</b>		
PUMP TYPE (Circle One): Submersible, Turbine, <b>Jet</b> Flowing Well, Other (Describe) _____		
POWER TYPE (Circle One): <b>Electric</b> , Tractor, Diesel, Gasoline, Butane, Other (Describe) _____		
Pump Capacity (GPM) <b>15</b>	No. of Stages <b>2</b>	Setting Depth <b>40'</b> FT.
PUMP TEST Well yielded <b>15</b> GPM with a drawdown of <b>10</b> ft. after <b>1</b> hours of pumping		

<b>WELL DATA</b>		
Well Depth <b>220'</b>	Casing Diameter (In.) <b>2"</b>	Casing Length (Ft.) <b>20'</b>
Type of Casing <b>PVC</b>	Hole Depth <b>220'</b>	Depth to Static Water Level <b>20'</b>
TYPE OF COMPLETION: (Circle One or More): <b>Natural Development</b> , Gravel Packed, Underreamed, Telescoped, Open Hole, Other		
Top of Lap Pipe or Reduction in Casing <b>FEET</b> IF TELESCOPED OR MORE THAN ONE SCREEN: USE BACK PAGE		

<b>LOG DATA</b>	
TYPE OF LOG RUN (Circle One): Electric, Gamma Ray, Density, Sonic, <b>No Log Run</b> , Neutron, Other (Describe) _____	
Name of Organization Running Log	

<b>SCREEN DATA</b>		
Diameter - Inches <b>2"</b>	Length - Feet <b>10'</b>	Slot Size - Inches <b>.0004</b>
Screen Type <b>PVC</b>	Depth to Bottom - Feet <b>220'</b>	

<b>GEOLOGIC DATA (Office Use Only)</b>			
Surface Elev.	Geologic Unit	Unit Thickness	Depth to Top
Subs. SWL	Date	Analysis	Aquifer Test

Driller's Remarks

**RECEIVED**

**NOV 30 1988**


Department of Natural Resources  
Bureau of Land & Water Resources

DESCRIPTION OF FORMATIONS ENCOUNTERED	FROM	TO	FORMATION	FORMATION
<b>Mud</b>	<b>0</b>	<b>20</b>		
<b>Sand</b>	<b>20</b>	<b>90</b>		
<b>Mud</b>	<b>90</b>	<b>170</b>		
<b>Sand</b>	<b>170</b>	<b>220</b>		

IF MORE SPACE IS NEEDED, USE BACK

If well telescopes please sketch and show depths.

GROUND LEVEL

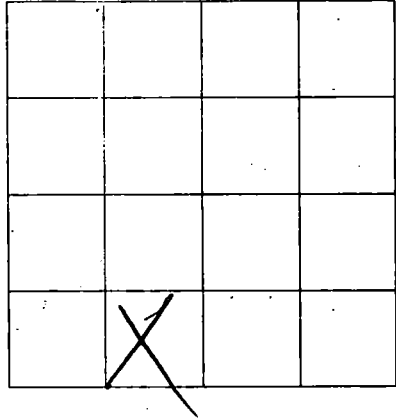

SECTION \_\_\_\_\_

Please indicate well location X.

ADDITIONAL INFORMATION

Multiple horizontal lines for additional information.

RECEIVED

2010 08 10

UNITED STATES DEPARTMENT OF THE INTERIOR  
BUREAU OF LAND MANAGEMENT

If more than one screen, show location of each on sketch.