

MISSISSIPPI DEPARTMENT OF NATURAL RESOURCES

Bureau of Land and Water Resources

P.O. Box 10631

Jackson, Mississippi 39209

WATER WELL DRILLERS LOG

COUNTY WELL LOCATED
HARRISON

WELL NUMBER **L2148** CODED

DATE WELL COMPLETED
6-05-90

PERMIT NUMBER **0-039**

NAME OF DRILLING FIRM
McGill

NAME & MAILING ADDRESS OF LANDOWNER
John Simmons

LANDON Rd.

Gupt., Ms. 39503

WELL LOCATION: SEC TOWNSHIP RANGE
17 7 N 11 E W

DISTANCE DIRECTION NEAREST TOWN
2 Miles **W** of **49**

OTHER LANDMARK
2 miles W 49

WELL PURPOSE Home, Irrigation, Municipal, Industrial, Fish Pond, etc.

PUMP DATA

PUMP TYPE (Circle One):
Submersible, Turbine, **Jet** Flowing Well,
Other (Describe) _____

POWER TYPE (Circle One):
Electric Tractor, Diesel, Gasoline, Butane,
Other (Describe) _____

Pump Capacity (GPM) No. of Stages Setting Depth
15 **2** **42** FT.

PUMP TEST

Well yielded **12** GPM with
a drawdown of _____ ft.
after **1** hours of pumping

WELL DATA

Well Depth 200'	Casing Diameter (In.) 2"	Casing Length (Ft.) 190'
Type of Casing PVC	Hole Depth 200'	Depth to Static Water Level 22'

TYPE OF COMPLETION: (Circle One or More):
 Gravel Packed, Underreamed, Telescoped,
 Natural Development, Open Hole, Other

Top of Lap Pipe or Reduction in Casing

FEET IF TELESCOPED OR MORE THAN ONE SCREEN: USE BACK PAGE

LOG DATA

TYPE OF LOG RUN (Circle One):
Electric, Gamma Ray, Density, Sonic, **No Log Run**, Neutron,
Other (Describe) _____

Name of Organization Running Log

SCREEN DATA

Diameter - Inches 2	Length - Feet 10	Slot Size - Inches .0006
Screen Type 2ch 40 PVC		Depth to Bottom - Feet 200'

GEOLOGIC DATA (Office Use Only)

Surface Elev.	Geologic Unit	Unit Thickness	Depth to Top
Subs. SWL	Core Analysis	Angle Test	

Driller's Remark

AUG 24 1990


Department of Natural Resources
Bureau of Land & Water Resources

DESCRIPTION OF FORMATIONS ENCOUNTERED	FROM	TO	FORMATIONS (Continued)	FROM	TO
SAND	0	20			
MUD	20	100			
MUD, SAND	100	120			
MUD	120	140			
SAND, MUD	140	160			
SAND	160	200			

IF MORE SPACE IS NEEDED, USE BACK

If well telescopes please
sketch and show depths.

GROUND LEVEL

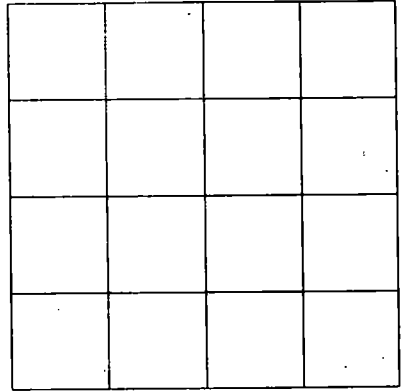

SECTION _____

Please indicate well location X.

ADDITIONAL INFORMATION

If more than one screen,
show location of each on sketch.