

**MISSISSIPPI DEPARTMENT OF ENVIRONMENTAL
QUALITY**

Office of Land and Water Resources

P. O. Box 10631
Jackson, MS 39289-0631
WATER WELL DRILLERS LOG

COUNTY WELL LOCATED
Harrison

WELL NUMBER L-2211 CODED

DATE WELL COMPLETED
3/10/01

PERMIT NUMBER
0-239

NAME OF DRILLING FIRM
Mc Millan Pump & well

NAME & MAILING ADDRESS OF LANDOWNER
J. D. Miller

Lafayette place

Summit, ms 39507

WELL LOCATION SEC TOWNSHIP RANGE

5 7 N 11 E
W

DISTANCE DIRECTION NEAREST TOWN

_____ Miles _____ of _____

OTHER LANDMARK

WELL PURPOSE Home Irrigation, Municipal, Industrial, Fish Pond, etc.

PUMP DATA

PUMP TYPE (Circle One):
Submersible, Turbine, Jet, Flowing Well,
Other (Describe) suction

POWER TYPE (Circle One):
 Electric, Tractor, Diesel, Gasoline, Butane,
Other (Describe) _____ H/P 1/2

Pump Capacity (GPM)	No. of Stages	Setting Depth
<u>5</u>	<u>1</u>	<u>15</u> FT.

PUMP TEST

Well yielded 5 GPM with
a drawdown of 3 ft.
after 1 hours of pumping

WELL DATA

Well Depth <u>30</u>	Casing Diameter (In) <u>2</u>	Casing Length (Ft) <u>20</u>
Type of Casing <u>pvc</u>	Hole Depth <u>30</u>	Depth to Static Water Level <u>5</u>

TYPE OF COMPLETION: (Circle One or More):
 Gravel Packed, Underreamed, Telescoped,
 Natural Development, Open Hole, Other

WELL GROUTED TO A DEPTH OF 10 FEET
Type Grout (circle one): Cement, Bentonite, or Mix

LOG DATA

TYPE OF LOG RUN (Circle One):
No Log Run, Electric, Gamma Ray, Density, Sonic, Neutron,
Other (Describe) Handwritten

Name of Organization Running Log

SCREEN DATA

Diameter - inches <u>2</u>	Length - Feet <u>10</u>	Slot Size - inches <u>.008</u>
Screen Type <u>pvc</u>		Depth to Bottom - Feet <u>30</u>

GEOLOGIC DATA (Office Use Only)

Surface Elev.	Geologic Unit	Unit Thickness	Depth to Top
Subs. SWL	Date	Analysis	Aquifer Test

Driller's Remarks

Top of Lap Pipe or Reduction in Casing

FEET IF TELESCOPED OR MORE THAN ONE SCREEN: USE BACK PAGE


DESCRIPTION OF FORMATIONS ENCOUNTERED	FROM	TO	FORMATIONS (Continued)	FROM	TO
<u>sand</u>	<u>0</u>	<u>30</u>			

RECD JUN 25 2001

IF MORE SPACE IS NEEDED, USE BACK

If well telescopes please
sketch and show depths.

GROUND LEVEL

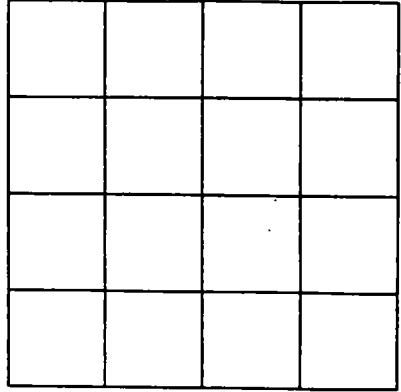

SECTION _____

Please indicate well location X.

ADDITIONAL INFORMATION

If more than one screen,
show location of each on sketch.