

HAR:

MISSISSIPPI BOARD OF WATER COMMISSIONERS

~~LH 45~~

K396809

WATER WELL DRILLERS LOG

6-16-64

Date: 6/16, 1964, Driller: Hattiesburg Butane County: Harrison
(Name)

(1) Owner of Land: Roy Pittman
(Name)

Support
(Address)

(2) Location: Highway 67-10 miles N Biloxi
1/4, 1/4, Sec. 3 T7R11
_____ miles _____ of _____
(distance) (direction) (Nearest Town)

(3) Topography: X
(Hilly) (Flat) (Level)

(4) Purpose of Well: domestic
(Domestic Irrigation
Municipal, Industrial, Other)

Description & Color of Materials Sand, Clay, Red Clay, Shell, etc.	Thick- ness Feet	Depth Feet
<u>Red sand</u>	<u>0-8</u>	
<u>white clay</u>	<u>8-16</u>	
<u>blue clay</u>	<u>16-40</u>	
<u>yellow clay</u>	<u>40-80</u>	
<u>blue clay</u>	<u>80-370</u>	
<u>blue sand</u>	<u>370-380</u>	
<u>blue clay</u>	<u>380-390</u>	

Information upon completion of well:

(1) Diameter 2 inches.

(2) Total Depth 390 feet.

(3) Water Level 18 feet below top of ground.

(4) Cased to _____, Size _____


(5) Screen: Size 2", Length 10'

(6) Were any formations sealed against pollution?
_____ yes, X no.

If YES depth of formation _____

Why _____

Drillers Remarks: _____

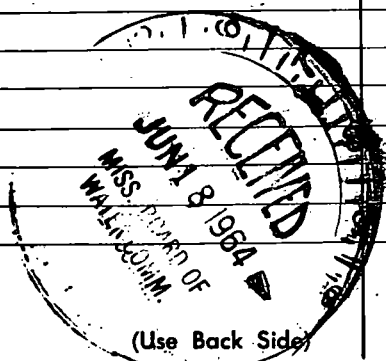

Well No.