

HARRISON

L-

8-28-71

MISSISSIPPI
 BOARD OF WATER COMMISSIONERS
 416 North State Street
 Jackson, Mississippi 39201

CODED

WATER WELL DRILLERS LOG

Aug 28 1971
date well completed

MFB Drilling Co.
firm name

Harrison
county well located

LANDOWNER: Mc Rae Turner

East Beach

Oulport, Miss

(mailing address)

WELL LOCATION:

sec 33 T. 7 S. R. 11
2 miles E of Oulport
 (distance) (direction) (nearest town)

WELL PURPOSE: Lawn
 (home, irrigation, municipal, industrial)

WELL COMPLETION DATA:

- (1) diameter (inches) 2"
- (2) total depth (feet) 164
- (3) static water level (feet) 8 below above top of ground.
- (4) casing PVC Total
 (material) (depth)
2" if telescope see back.
 (size)
- (5) screen 10 FT 14 FT
 (length) (depth to top)
2" PVC 010
 (size) (material)
- (6) pump 1 1/2 25
 (HP) (yield gpm)
220V 1P
 (type power)
- (7) electric log No
 (yes or no)

(organization running log)

(8) how well bottom plugged

2" PVC Cap

DRILLERS REMARKS:

10 FT Screen + 10 FT Tailpipe

description of formations encountered

from to

Sand -	0	25
Soft Grey Clay	25	42
Sand - white	42	71
Blue Clay	71	122
Sand - Grey	122	130
Blue Clay	130	135
Grey Sand	135	154
Blue Clay and Sand		
Be Lake	154	164


CODED

SEP 1 1971

MISS. BD. OF WATER COMM

If well telescopes please sketch and show depths.

GROUND LEVEL

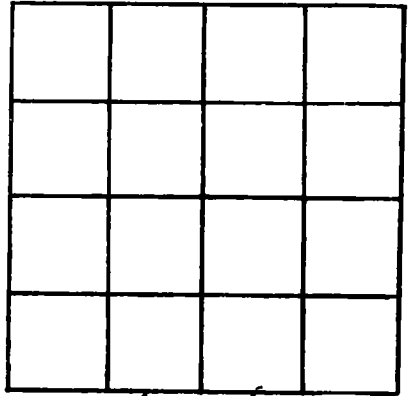

Well-located - 4 Hours East
of Newes Ave on Highway 90
in Culbert SECTION _____
Please indicate well location X.

ADDITIONAL INFORMATION

A series of horizontal lines for providing additional information, consisting of approximately 18 lines.

If more than one screen, show locations of each on sketch.