

HAR.

MISSISSIPPI BOARD OF WATER COMMISSIONERS

L

10-8-63

WATER WELL DRILLERS LOG

6

Date: Oct 8, 1963, Driller: Joe Miller County Harrison

(Name)

(1) Owner of Land: Sal Titano

(Name)

RRH Sulfur Miss
(Address)

(2) Location: 1/4, 1/4, Sec. T R

5 miles NE of Gulfport
(distance) (direction) (Nearest town)

(3) Topography: Flat
(Hilly) (Flat) (Level)

(4) Purpose of Well: Domestic
(Domestic Irrigation
Municipal, Industrial, Other)

Description & Color of Materials
Sand, Clay, Red Clay, Shell, etc.

Thick-
ness
Feet

Depth
Feet

Surface	10	10
Red Sand	14	24
Hard (Like Sand Stone)	1	25
White Clay	5	30
Blue Clay	40	70
Fine Sand (Hard)	15	85
Fine Sand	10	95
Sand (Coarse)	11	106
Sand	7	113
Red Hard	3	116
Blue Clay	3	119


Information upon completion of well:

- (1) Diameter 2 inches.
- (2) Total Depth 119 feet.
- (3) Water Level 26 feet below top of ground.
- (4) Cased to 110, Size 2
- (5) Screen: Size 2", Length 6
- (6) Were any formations sealed against pollution?
no

If YES depth of formation _____

Why _____

Drillers Remarks: _____

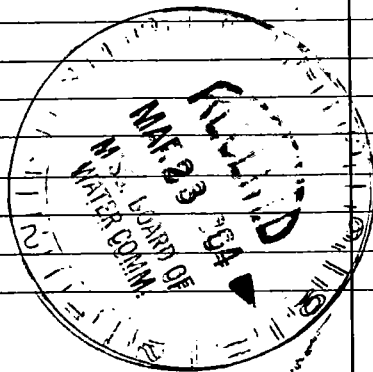

(Use Back Side)

Well No.

Wesleyan

Wesleyan Road.



Alley 49

Wesleyan