

L
9-21-62

WATER WELL DRILLERS LOG

Date: 9-21, 1962, Driller: C. T. SWITZER WELL CO. County Harrison

(Name)

	Description & Color of Materials Sand, Clay, Red Clay, Shell, etc.	Thick- ness Feet	Depth Feet
(1) Owner of Land: <u>Robert W. Davis</u> (Name)	Clay	00	15
<u>Jefferson, Miss.</u> (Address)	Sand	15	30
(2) Location: _____ 1/4, _____ 1/4, Sec. _____ T. R. _____	Clay	30	40
_____ miles _____ of _____ (distance) (direction) (Nearest Town)	Clay, red hard	40	80
(3) Topography: _____ (Hilly) (Flat) (Level)	Clay	80	95
(4) Purpose of Well: <u>Domestic</u> (Domestic Irrigation Municipal, Industrial, Other)	Sand	95	100
	Sand, good	100	110
	Clay	110	120
	Sand good	120	140
	Clay	140	160
	Sand, good	160	213


Information upon completion of well:

- (1) Diameter 2" inches.
- (2) Total Depth 213 feet.
- (3) Water Level 24' feet below top of ground.
- (4) Cased to 213', Size 2"
- (5) Screen: Size 2", Length 10'
- (6) Were any formations sealed against pollution?
 yes, no.

If YES depth of formation _____

Why Health Dept. Requirements

Drillers Remarks: _____

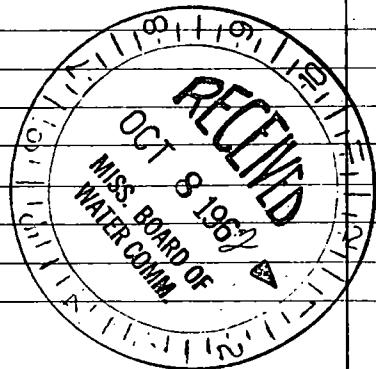

(Use Back Side)

Well No.

