

L

10-15-64

WATER WELL DRILLERS LOG

Date: Oct 15, 1964, Driller: Joe Miller County Harrison


(1) Owner of Land: BB Lett (Name) R.R.# Sulfur, Miss (Address) (2) Location: 1/4, 1/4, Sec. T R (3) Topography: Flat (4) Purpose of Well: Domestic

Table with 4 columns: Description & Color of Materials, Thickness Feet, Depth Feet. Rows include Surface, Wh Clay, Red Clay, Red & Red Clay, Wh Clay, Blue Clay, Sand Br. & G, Blue Clay, Fine Gray Sand, Hard Clay, Clay & Wood, Sand Br. Sand, Gray Sand, Fair, Silty Sand, Hard Blue Clay.

Information upon completion of well:

(1) Diameter 2 inches. (2) Total Depth 221 feet. (3) Water Level 8 feet below top of ground. (4) Cased to 217, Size 2. (5) Screen: Size 2, Length 10. (6) Were any formations sealed against pollution? yes, no.

If YES depth of formation Why Drillers Remarks:

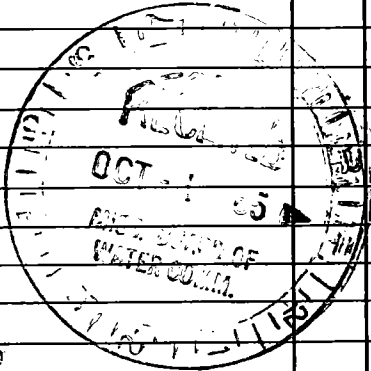

(Use Back Side)

Well No.

S

B/B
Salt

Kendon Rd

H/K 49

~~H/K 49~~

W

N

E

