

MISSISSIPPI BOARD OF WATER COMMISSIONERS

WATER WELL DRILLERS LOG

Date: 6/9, 1961, Driller: Sutter Well Works County Harrison

(Name)

(1) Owner of Land: Sam Alman, Sr.

(Name)

Gulfport, Miss

(Address)

(2) Location: 1/4, 1/4, Sec. T. R.

1/2 miles N of Gulfport

(distance)

(direction)

(Nearest town)

(3) Topography: flat

(Hilly)

(Flat)

(Level)

(4) Purpose of Well: Industrial

(Domestic Irrigation
Municipal, Industrial, Other)

Description & Color of Materials
Sand, Clay, Red Clay, Shell, etc.

Thick-
ness
Feet

Depth
Feet

Surface sand
Clay
sand

20
35
15

20
55
70

Information upon completion of well:

(1) Diameter 2 inches.

(2) Total Depth 70 feet.

(3) Water Level 4 feet below top of ground.

(4) Cased to all, Size 2"

(5) Screen: Size 2", Length 5'


(6) Were any formations sealed against pollution?

 yes, ✓ no.

If YES depth of formation

Why

Drillers Remarks:

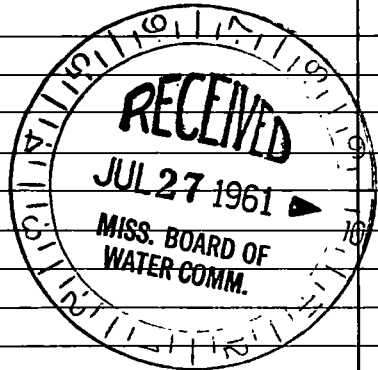

(Use Back Side)

Well No.

[Faint, illegible handwritten text, possibly bleed-through from the reverse side of the page]

[Faint handwritten word, possibly "Hull"]

[Faint handwritten word, possibly "Hull"]

[Faint handwritten word, possibly "Hull"]

[Faint handwritten word, possibly "of"]

[Faint handwritten word, possibly "of"]

[Faint handwritten word, possibly "of"]