

HAR.

MISSISSIPPI BOARD OF WATER COMMISSIONERS

(P)

L  
2-8-62

WATER WELL DRILLERS LOG

Date: 2-8, 1962, Driller: E. I. SWITZER WELL CO. County Harrison  
(Name)

(1) Owner of Land: Robert Street  
(Name)  
Box 1111 Gulfport  
(Address)

(2) Location: \_\_\_\_\_ 1/4, \_\_\_\_\_ 1/4, Sec. \_\_\_\_\_ T. R. \_\_\_\_\_  
\_\_\_\_\_ miles \_\_\_\_\_ of \_\_\_\_\_  
(distance) (direction) (Nearest Town)

(3) Topography: X  
(Hilly) (Flat) (Level)

(4) Purpose of Well: Domestic  
(Domestic Irrigation  
Municipal, Industrial, Other)

Description & Color of Materials Sand, Clay, Red Clay, Shell, etc.	Thick- ness Feet	Depth Feet
Clay	00	10
Sand	10	20
Sand, gravel	20	81
Clay	81	91
Sand	91	102
Sand, fine	102	122
Clay	122	162
Sand, good	162	202

Information upon completion of well:

(1) Diameter 2 inches.

(2) Total Depth 202 feet.

(3) Water Level 3' + feet below top of ground.


(4) Cased to 202', Size 2"

(5) Screen: Size 2", Length 10'

(6) Were any formations sealed against pollution?  
✓ yes, \_\_\_\_\_ no.

If YES depth of formation \_\_\_\_\_  
Why Health Dept Requirement

Drillers Remarks: \_\_\_\_\_  
\_\_\_\_\_  
\_\_\_\_\_

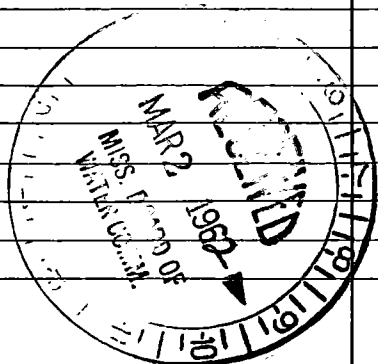

Well No. \_\_\_\_\_

