

HAR.

MISSISSIPPI BOARD OF WATER COMMISSIONERS

L K 316 805

(T)

L
7-9-62

WATER WELL DRILLERS LOG

W 413602

Date: 7-9, 1962, Driller: C. T. SWITZER WELL CO. County Norfolk

(Name)

	Description & Color of Materials Sand, Clay, Red Clay, Shell, etc.	Thick- ness Feet	Depth Feet
(1) Owner of Land: <u>Ray Taylor</u> (Name)	Clay	00	19
<u>Rt. 2, Box 436, Gulfport</u> (Address)	Sand	12	20
(2) Location: <u>1/4</u> , <u>1/4</u> , Sec. <u>1</u> T <u>R</u>	Clay	20	20
<u>1/2</u> miles, of <u>Went</u> (distance) (direction) (Nearest Town)	Sand	70	90
(3) Topography: <u>✓</u> (Hilly) (Flat) (Level)	Sand, good	80	120
(4) Purpose of Well: <u>Domestic</u> (Domestic Irrigation Municipal, Industrial, Other)	Clay	120	160
	Clay & sand str.	160	190
	Clay	180	228
	Sand	228	240
	Sand, good	240	250

Information upon completion of well:


- (1) Diameter 2 inches.
- (2) Total Depth 250 feet.
- (3) Water Level 2' feet below top of ground.
- (4) Cased to 250', Size 2"
- (5) Screen: Size 2", Length 10'
- (6) Were any formations sealed against pollution?

✓ yes, no.

If YES depth of formation

Why Health Dept. Requirement

Drillers Remarks:

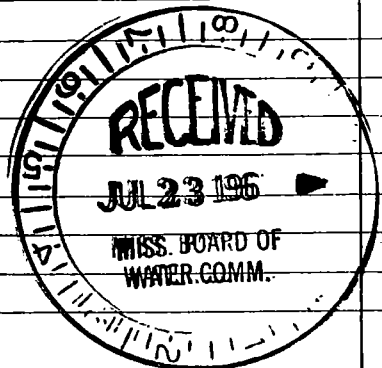

(Use Back Side)

Well No.