

HAR. MISSISSIPPI BOARD OF WATER COMMISSIONERS


M 0003
7-26-63 WATER WELL DRILLERS LOG

C. T. SWITZER WELL CO.

Date: 7/26, 1963, Driller: _____ County: Harrison

(Name)

	Description & Color of Materials Sand, Clay, Red Clay, Shell, etc.	Thick- ness Feet	Depth Feet
(1) Owner of Land: <u>Central Shopping Center</u> (Name)	sand	00	39
<u>Highway 90, P. H. Huffpost</u> (Address)	mud	39	45
(2) Location: _____ 1/4, _____ 1/4, Sec. _____ T. R. _____	sand	45	63
_____ miles _____ of _____ (distance) (direction) (Nearest Town)	clay	63	76
(3) Topography: _____ (Hilly) (Flat) (Level)	clay w/ sand shls	76	109
(4) Purpose of Well: <u>Commercial</u> (Domestic Irrigation, Municipal, Industrial, Other)	clay	109	132
Information upon completion of well:	clay w/ sand shls	132	155
(1) Diameter <u>12 1/2</u> inches.	clay	155	178
(2) Total Depth <u>662'</u> feet.	clay w/ sand shls	178	200
(3) Water Level <u>16'</u> feet below top of ground.	sand, fine	200	234
(4) Cased to <u>662'</u> , Size <u>12 1/2"</u>	clay	234	266
(5) Screen: Size <u>8"</u> , Length <u>60'</u>	sand, fine	266	270
(6) Were any formations sealed against pollution? <u>✓</u> yes, _____ no.	sand	270	284
If YES depth of formation _____	clay	284	313
Why <u>Health Dept. Requirement</u>	soft mud	313	334
Drillers Remarks: _____	clay	334	378
_____	shale	378	422
_____	sand, good	422	466
_____	sand	466	498
_____	clay	498	510
_____	shale w/ sand shls	510	531
_____	shale & fuller earth	531	554
_____	shale & sand shls	554	567
_____	sand w/ shls	567	662'
_____	sand		

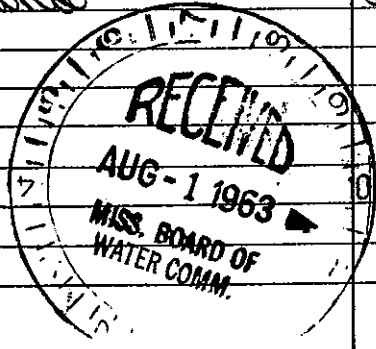

(Use Back Side)

Well No.

Mail this copy to Board of Water Commissioners 429 Miss. St. Jackson, Mi: