

HAR.

MISSISSIPPI BOARD OF WATER COMMISSIONERS

M6

M6

GW 08728

WATER WELL DRILLERS LOG

7-1-63

Date: 4-1, 1963, Driller: C. T. SWITZER WELL CO. County: Harrison

(Name)

(1) Owner of Land: City of Biloxi (Name)

Bayview Drive (Address)

(2) Location: 1/4, 1/4, Sec. T. R. 529 T75 R9W miles of (distance) (direction) (Nearest Town)

(3) Topography: (Hilly) (Flat) (Level)

(4) Purpose of Well: Commercial (Domestic Irrigation Municipal, Industrial, Other)


Description & Color of Materials Sand, Clay, Red Clay, Shell, etc.	Thick- ness Feet	Depth Feet
sand	14	14
clay	14	18
sand	18	92
clay	92	138
sand, fine	133	144
sand	144	152
clay	152	286
clay & sand shls	286	306
sand w/ clay shls	306	326
clay	326	384
sand, good	384	461

Information upon completion of well:

- (1) Diameter: 14x10 inches.
- (2) Total Depth: 465 feet.
- (3) Water Level: 9' feet below top of ground.
- (4) Cased to: 465', Size: 14x10"
- (5) Screen: Size: 10", Length: 44'
- (6) Were any formations sealed against pollution?  yes,  no.

If YES depth of formation  
Why: Health Dept requirement

Drillers Remarks:

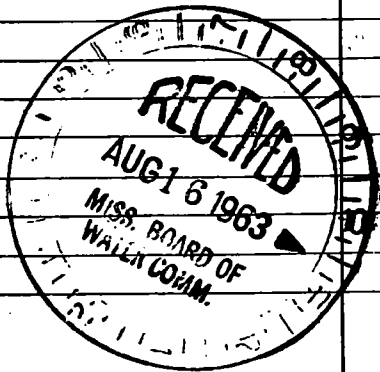

(Use Back Side)

Well No.

