

HAR.

E. Log # 29

M70  
6-28-63

WATER WELL DRILLERS LOG

CODED M7

C. T. SWITZER WELL CO.

Date: 6/28, 1963, Driller: \_\_\_\_\_ County: Harrison

(Name)

(1) Owner of Land: Woodruff Road  
(Name)

off base, S. P. track  
(Address)

(2) Location: 1/4, 1/4, Sec. T. R.  
27 770  
miles \_\_\_\_\_ of \_\_\_\_\_  
(distance) (direction) (Nearest Town)

(3) Topography:  (Hilly)  (Flat)  (Level)

(4) Purpose of Well: Commercial  
(Domestic Irrigation, Municipal, Industrial, Other)

Description & Color of Materials Sand, Clay, Red Clay, Shell, etc.	Thick- ness Feet	Depth Feet
<u>sand</u>	<u>00</u>	<u>51</u>
<u>clay</u>	<u>51</u>	<u>64</u>
<u>sand</u>	<u>67</u>	<u>74</u>
<u>clay</u>	<u>74</u>	<u>89</u>
<u>sand</u>	<u>89</u>	<u>97</u>
<u>clay</u>	<u>97</u>	<u>109</u>
<u>clay w/ sand shls</u>	<u>109</u>	<u>125</u>
<u>sand</u>	<u>125</u>	<u>137</u>
<u>clay</u>	<u>137</u>	<u>198</u>
<u>sand</u>	<u>198</u>	<u>250</u>
<u>clay</u>	<u>250</u>	<u>250</u>
<u>sand</u>	<u>230</u>	<u>238</u>
<u>clay</u>	<u>238</u>	<u>270</u>
<u>clay w/ sand shls</u>	<u>270</u>	<u>290</u>
<u>clay</u>	<u>290</u>	<u>326</u>
<u>sand</u>	<u>326</u>	<u>334</u>
<u>clay</u>	<u>334</u>	<u>341</u>
<u>sand</u>	<u>341</u>	<u>347</u>
<u>clay</u>	<u>347</u>	<u>351</u>
<u>clay w/ sand shls</u>	<u>351</u>	<u>341</u>
<u>clay</u>	<u>341</u>	<u>391</u>
<u>clay w/ shale</u>	<u>391</u>	<u>412</u>
<u>clay</u>	<u>412</u>	<u>452</u>
<u>clay w/ shale</u>	<u>452</u>	<u>472</u>
<u>clay</u>	<u>472</u>	<u>492</u>
<u>clay w/ sand shls</u>	<u>492</u>	<u>512</u>
<u>clay w/ sand shls</u>	<u>512</u>	<u>533</u>
<u>clay w/ sand shls</u>	<u>533</u>	<u>543</u>
<u>clay w/ sand shls</u>	<u>543</u>	<u>553</u>
<u>sand</u>	<u>553</u>	<u>574</u>
<u>sand</u>	<u>574</u>	<u>643</u>
<u>clay</u>	<u>643</u>	<u>656</u>

Information upon completion of well:

(1) Diameter: 12 1/8 inches.

(2) Total Depth: 1036 feet.

(3) Water Level: 8' feet below top of ground.

(4) Cased to: 1036', Size: 12 1/8"

(5) Screen: Size 8", Length 60'


(6) Were any formations sealed against pollution?  
 yes,  no.

If YES depth of formation \_\_\_\_\_

Why: Water Dept. requirement

Drillers Remarks: \_\_\_\_\_

CODED

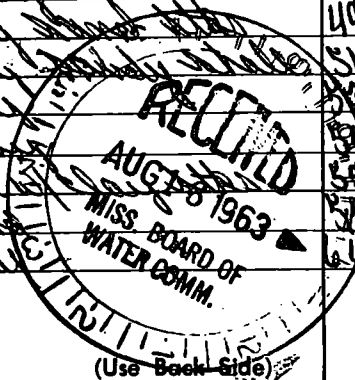

Well No.

