


Harrison
 170008
 4-66

MISSISSIPPI BOARD OF WATER COMMISSIONERS

WATER WELL DRILLERS LOG

Date: 4-6-66, 19 , Driller: C. T. Bentley Well Co County Harrison
 (Name)

(1) Owner of Land: <u>Moran Land Co.</u> (Name)	Description & Color of Materials Sand, Clay, Red Clay, Shell, etc.	Thick- ness Feet	Depth Feet
<u>East Beach, Belzoni Miss</u> (Address)	<u>Quartz shells</u>	<u>0</u>	<u>6</u>
	<u>Clay</u>	<u>6</u>	<u>26</u>
(2) Location: <u> </u> / <u> </u> , <u> </u> / <u> </u> , Sec. <u> </u> T <u> </u> R <u> </u> <u> </u> miles <u> </u> of <u> </u> (distance) (direction) (Nearest Town)	<u>Sand</u>	<u>26</u>	<u>39</u>
	<u>Clay</u>	<u>39</u>	<u>52</u>
(3) Topography: <u>X</u> (Hilly) (Flat) (Level),	<u>Mixed sand + clay</u>	<u>52</u>	<u>85</u>
	<u>Soft clay</u>	<u>85</u>	<u>107</u>
(4) Purpose of Well: <u>Commercial</u> (Domestic Irrigation Municipal, Industrial, Other)	<u>Sand</u>	<u>107</u>	<u>121</u>
	<u>Mixed</u>	<u>121</u>	<u>150</u>
Information upon completion of well:	<u>Clay</u>	<u>150</u>	<u>173</u>
	<u>Mixed</u>	<u>173</u>	<u>240</u>
(1) Diameter <u>8" x 12"</u> inches.	<u>Clay</u>	<u>240</u>	<u>244</u>
(2) Total Depth <u>1002</u> feet.	<u>Rock</u>	<u>244</u>	<u>246</u>
(3) Water Level <u>7' 6" +</u> feet below top of ground. <u>to 104' - 12"</u>	<u>Clay</u>	<u>246</u>	<u>261</u>
(4) Cased to <u>1002</u> , Size <u>8" x 12"</u> .	<u>Hard clay</u>	<u>261</u>	<u>284</u>
(5) Screen: Size <u>20' 8 1/2" x 40' 6 1/2"</u> Length <u>60'</u> .	<u>Clay + shales</u>	<u>284</u>	<u>331</u>
(6) Were any formations sealed against pollution? <u>X</u> yes, <u> </u> no.	<u>Clay</u>	<u>331</u>	<u>358</u>
If YES depth of formation <u> </u>	<u>Sand</u>	<u>358</u>	<u>366</u>
Why <u>Health Dept. Payments</u>	<u>Clay</u>	<u>366</u>	<u>375</u>
Drillers Remarks: <u> </u>	<u>Sand</u>	<u>375</u>	<u>385</u>
	<u>Clay</u>	<u>385</u>	<u>418</u>
	<u>Clay + sand shales</u>	<u>418</u>	<u>460</u>
	<u>Clay</u>	<u>460</u>	<u>471</u>
	<u>Sand</u>	<u>471</u>	<u>482</u>
	<u>Sand + shales</u>	<u>482</u>	<u>505</u>
	<u>Sand</u>	<u>505</u>	<u>515</u>
	<u>Rock</u>	<u>515</u>	<u>525</u>
	<u>Clay</u>	<u>525</u>	<u>528</u>
	<u>Clay + shales</u>	<u>528</u>	<u>550</u>
	<u>Clay</u>	<u>550</u>	<u>593</u>
	<u>Mixed</u>	<u>593</u>	<u>616</u>
	<u>Shale</u>	<u>616</u>	<u>626</u>
	<u>Sand</u>	<u>626</u>	<u>639</u>

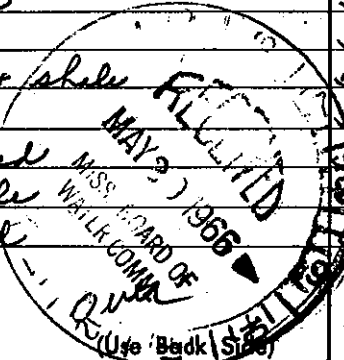

Well No.