

HAR.

M 29

4-22-64

WATER WELL DRILLERS LOG

CODED

Date: 4-22, 1964, Driller: Suttler Well Works County Harrison

(Name)

(1) Owner of Land: Miss. City Water Co.
(Name)

Miss. City, Miss.
(Address)

(2) Location: 1/4, 29 7 10 R
1/4, Sec. 10 R

1/4 miles W, of Miss. City,
(distance) (direction) (Nearest Town)

(3) Topography: flat
(Hilly) (Flat) (Level)

(4) Purpose of Well: Municipal
(Domestic Irrigation
Municipal, Industrial, Other)

Description & Color of Materials Sand, Clay, Red Clay, Shell, etc.	Thick- ness Feet	Depth Feet
<u>Sand</u>	<u>175</u>	<u>175</u>
<u>Clay</u>	<u>55</u>	<u>230</u>
<u>Sand</u>	<u>42</u>	<u>272</u>
<u>Sand - Clay - muck</u>	<u>128</u>	<u>400</u>
<u>Clay</u>	<u>302</u>	<u>702</u>
<u>Sand</u>	<u>35</u>	<u>737</u>
<u>Clay</u>	<u>18</u>	<u>755</u>
<u>Sand</u>	<u>70</u>	<u>825</u>

Information upon completion of well:

(1) Diameter 4 inches.

(2) Total Depth 825 feet.

(3) Water Level 9 feet below top of ground.

(4) Cased to all, Size 4"

(5) Screen: Size 4", Length 20'


(6) Were any formations sealed against pollution?
 yes, no.

CODED

If YES depth of formation _____

Why _____

Drillers Remarks: _____

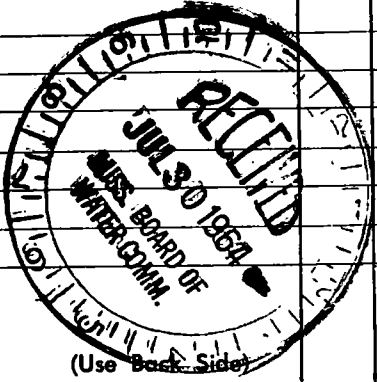

Well No.

0000