

M
3-22-64

WATER WELL DRILLERS LOG

M 30

Date: 3-22, 1964, Driller: C. I. SWITZER WELL CO. County: Jackson
(Name)

(1) Owner of Land: E. H. Scarborough
(Name)
Leamon Rd, Baloxi
(Address)

(2) Location: 1/4, 1/4, Sec. T. R.
 miles, of
(distance) (direction) (Nearest Town)

(3) Topography: ✓
(Hilly) (Flat) (Level)

(4) Purpose of Well: Domestic
(Domestic Irrigation
Municipal, Industrial, Other)

Description & Color of Materials Sand, Clay, Red Clay, Shell, etc.	Thick- ness Feet	Depth Feet
sand	10	15
clay	13	26
clay & sand	26	44
clay	44	109
clay & fine sand	109	133
clay	133	199
sand w/ clay shls	199	220
sand, medium	220	245
sand, o.k.	245	245

Information upon completion of well:

(1) Diameter 2" inches.

(2) Total Depth 245 feet.

(3) Water Level 14' feet below top of ground.


(4) Cased to 245', Size 2"

(5) Screen: Size 2", Length 10'

(6) Were any formations sealed against pollution?
✓ yes, no.

If YES depth of formation
Why Health Dept. requirement

Drillers Remarks:

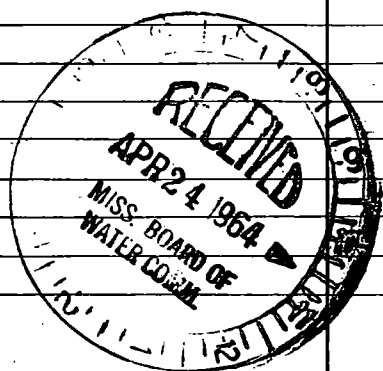

(Use Back Side)

Well No.

