

HAR.  
M. 32  
7-26-62

MISSISSIPPI BOARD

WATER WELL DRILLERS LOG

**CODED**

M32

Date: 7-26, 1962, Driller: Sutter Well Works County: Harrison

(Name)

- (1) Owner of Land: Handshere Water Co.  
(Name)  
Handshere, Miss.  
(Address)
- (2) Location: NE 1/4, SW 1/4, Sec. 29 T15R10.00  
1 miles NE, of Miss. City  
(distance) (direction) (Nearest Town)
- (3) Topography: flat  
(Hilly) (Flat) (Level)
- (4) Purpose of Well: Industrial  
(Domestic Irrigation  
Municipal, Industrial, Other)

Description & Color of Materials Sand, Clay, Red Clay, Shell, etc.	Thick- ness Feet	Depth Feet
<u>Sand - gravel</u>	<u>80</u>	<u>80</u>
<u>Clay</u>	<u>244</u>	<u>324</u>
<u>Sand</u>	<u>24</u>	<u>348</u>
<u>Clay</u>	<u>102</u>	<u>450</u>
<u>Sand</u>	<u>62</u>	<u>512</u>
<u>Clay</u>	<u>250</u>	<u>762</u>
<u>Sand</u>	<u>78</u>	<u>840</u>


Information upon completion of well:

- (1) Diameter 4 1/2 inches.
- (2) Total Depth 840 feet.
- (3) Water Level 14 feet below top of ground.
- (4) Cased to all, Size 4" 46"  
tip 105' 46"
- (5) Screen: Size 4", Length 30'
- (6) Were any formations sealed against pollution?  
 yes,  no.

If YES depth of formation 15 feet  
Why Health Dept. requirements

Drillers Remarks:

**CODED**

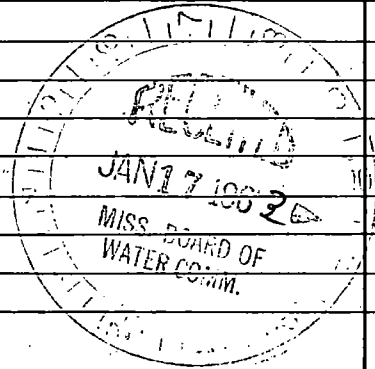

(Use Back Side)

Well No.

