

HAR. MISSISSIPPI BOARD OF WATER COMMISSIONERS

M 36
9-5262

WATER WELL DRILLERS LOG

Date: 9-5, 1962, Driller: C. I. SWITZER WELL CO. County: HARRISON

(Name)

(1) Owner of Land:	Description & Color of Materials Sand, Clay, Red Clay, Shell, etc.	Thick- ness Feet	Depth Feet
(Name) <u>Henry J. Jip</u>	Clay	00	20
(Address) <u>Old Hwy. 90, Biloxi</u>	Sand, good	20	40
(2) Location: <u>1/4</u> , <u>1/4</u> , Sec. <u>T 10 R</u>	Sand & clay, dks	60	80
_____ miles _____ of _____	Clay	40	60
(distance) (direction) (Nearest Town)	Sand, good	90	90
(3) Topography: <input checked="" type="checkbox"/> (Hilly) <input type="checkbox"/> (Flat) <input type="checkbox"/> (Level)	Clay	90	105
(4) Purpose of Well: <u>Domestic</u>	Sand	105	120
(Domestic Irrigation, Municipal, Industrial, Other)	Sand, good	120	150


Information upon completion of well:

- (1) Diameter 2 inches.
- (2) Total Depth 150 feet.
- (3) Water Level 2' feet below top of ground.
- (4) Cased to 150', Size 2"
- (5) Screen: Size 2", Length 10'
- (6) Were any formations sealed against pollution?
 yes, no.

If YES depth of formation

Why Health Dept. Requirement

Drillers Remarks:

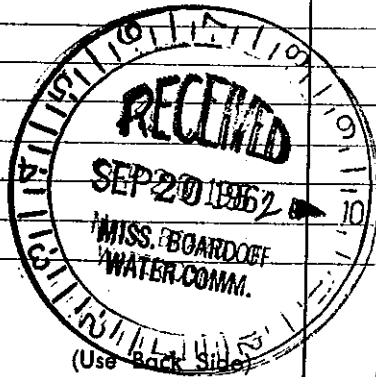

Well No.

Mail this copy to Board of Water Commissioners 429 Miss. St. Jackson, Miss.