

M48

9-10-64

WATER WELL DRILLERS LOG

**CODED**

M48

Date: 9-10-64, 19\_\_\_, Driller: Surtzger Well Co County Harrison  
(Name)

(1) Owner of Land: Miss Gulf Coast Junior College Dist  
(Name)  
Corner De Keyser + Surtzger Rd  
(Address)  
(2) Location: SW 1/4, NE 1/4, Sec. 29 T7S R10W  
(distance) (direction) of (Nearest Town)  
(3) Topography: \_\_\_\_\_  
(Hilly) (Flat) (Level)  
(4) Purpose of Well: Municipal  
(Domestic Irrigation Municipal, Industrial, Other)

Description & Color of Materials Sand, Clay, Red Clay, Shell, etc.	Thick- ness Feet	Depth Feet
<u>Sand</u>	<u>0</u>	<u>20</u>
<u>Clay + sand</u>	<u>20</u>	<u>38</u>
<u>Clay</u>	<u>38</u>	<u>125</u>
<u>Mixed clay + sand</u>	<u>125</u>	<u>134</u>
<u>Clay</u>	<u>134</u>	<u>157</u>
<u>Clay + sand streaks</u>	<u>157</u>	<u>179</u>
<u>Clay</u>	<u>179</u>	<u>208</u>
<u>Sand</u>	<u>208</u>	<u>221</u>
<u>Clay</u>	<u>221</u>	<u>274</u>
<u>Fine sand</u>	<u>274</u>	<u>284</u>
<u>Clay</u>	<u>284</u>	<u>309</u>
<u>Clay + shells</u>	<u>309</u>	<u>331</u>
<u>Shells</u>	<u>331</u>	<u>352</u>
<u>Shells - Clay</u>	<u>352</u>	<u>375</u>
<u>Clay</u>	<u>375</u>	<u>465</u>
<u>Sand</u>	<u>465</u>	<u>476</u>
<u>Mixed sand + clay</u>	<u>476</u>	<u>479</u>
<u>Clay</u>	<u>479</u>	<u>521</u>
<u>Clay, sand</u>	<u>521</u>	<u>542</u>
<u>Clay + sand streaks</u>	<u>542</u>	<u>565</u>
<u>Sand, fine</u>	<u>565</u>	<u>587</u>
<u>Sand, good</u>	<u>587</u>	<u>670</u>


Information upon completion of well:

(1) Diameter 4x6 inches.  
(2) Total Depth 670 feet.  
(3) Water Level 18' 6" feet below top of ground. top 210' - 6"  
(4) Cased to 670', Size 4"  
(5) Screen: Size 4", Length 60' 10"  
(6) Were any formations sealed against pollution?  
X yes, \_\_\_\_\_ no.

If YES depth of formation \_\_\_\_\_

Why Health Dept Permits

Drillers Remarks: \_\_\_\_\_

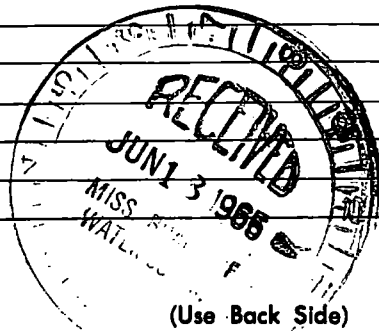

Well No.

