

HARRISON

M 80

3-68

MISSISSIPPI
 BOARD OF WATER COMMISSIONERS
 416 North State Street
 Jackson, Mississippi 39201

WATER WELL DRILLERS LOG

march 27 1968
date well completed

L. L. Garland
firm name

Harrison
county well located

LANDOWNER: Albert Raymond

Rt. 2 Box 347

Biloxi, Miss.
(mailing address)

WELL LOCATION:

sec. 9 T 7 N R 9 E
 (distance) (direction) (nearest town)

3 miles north of Biloxi

WELL PURPOSE: Home
(home, irrigation, municipal, industrial)

WELL COMPLETION DATA:

(1) diameter (inches) 2"
 (2) total depth (feet) 714
 (3) static water level (feet) _____ below above
 (top of ground)

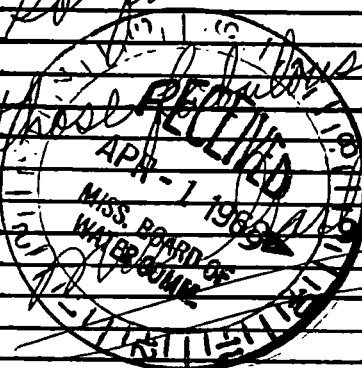
(4) casing _____ (material) _____ (depth) _____
 _____ (size) if telescope see back.

(5) screen 12 _____ (length) _____ (depth to top)
2" _____ (size) _____ (material) _____

(6) pump 1 _____ (HP) _____ (yield gpm)
electric _____ (type power)

(7) electric log no _____ (yes or no)
 _____ (organization running log)

(8) how well bottom plugged wash valve

description of formations encountered	from	to
<p>Sorry but still cannot find section logs townships and PO both on map and</p> 		

DRILLERS REMARKS:

well set in 31 ft of sand, slightly flowing

If well telescopes please sketch and show depths.

GROUND LEVEL

	X		

SECTION 9

Please indicate well location X.

ADDITIONAL INFORMATION

If more than one screen, show locations of each on sketch.