

M 149 J 17, 1993

5-21-64

WATER WELL DRILLERS LOG

**CODED** 149

C. T. SWITZER WELL CO.

Date: 5-21, 1964, Driller: \_\_\_\_\_ County: Harrison

(Name)

(1) Owner of Land: Wesley James Weber  
 (Name)  
College Park Sub - Hardscrabble  
 (Address)

(2) Location: 3 2 7/10  
 \_\_\_\_\_ miles \_\_\_\_\_ of \_\_\_\_\_  
 (distance) (direction) (Nearest Town)

(3) Topography:  (Hilly)  (Flat)  (Level)

(4) Purpose of Well: Commercial  
 (Domestic Irrigation, Municipal, Industrial, Other)

Description & Color of Materials Sand, Clay, Red Clay, Shell, etc.	Thick- ness Feet	Depth Feet
sand	00	35
clay	85	45
sand	45	71
clay	71	104
sand	104	116
clay	116	122
sand	22	130
clay	130	151
clay & sand	151	193
clay	193	233
sand	233	239
sand, gravel	239	260
sand	260	268
clay	268	302
clay & sand shls	302	348
shale	348	398
sand	398	424
shale	424	479
shale & sand fine	479	504
shale & sand, fine	504	524
shale & sand shls	524	583
shale	548	583
sand	583	598
sand & shale	598	638
shale	638	660
shale & sand	660	684
shale	684	705
shale & sand	705	726
shale	726	747
sand w/ shells	747	792
sand	792	835
shale	835	864

**CODED**

Information upon completion of well:

(1) Diameter 8 1/2 inches.

(2) Total Depth 1033 feet.

(3) Water Level 2 1/2 feet below top of ground.

(4) Cased to 1033', Size 8 1/2"


(5) Screen: Size 8", Length 60'

(6) Were any formations sealed against pollution?  
 yes, \_\_\_\_\_ no.

If YES depth of formation \_\_\_\_\_

Why: Health Dept. requirement

Drillers Remarks: \_\_\_\_\_

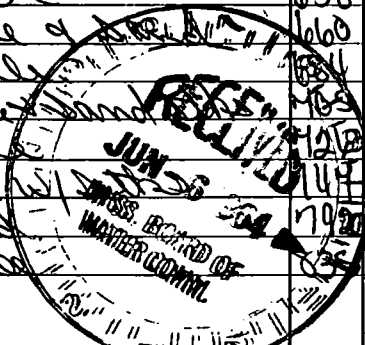

(Use Back Side)

Well No.

867 - 877 sand  
877 - 941 shal  
941 - 962 sand, fine  
962 - 1033 sand