

Harrison
 M. 151
 6-67

MISSISSIPPI
 BOARD OF WATER COMMISSIONERS
 416 North State Street
 Jackson, Mississippi 39201

CODED

WATER WELL DRILLERS LOG

6-16 1967 date well completed
 Switzer Well Co. firm name
 Harrison county well located

LANDOWNER: Gulf Coast
 Hotels, Inc. (mailing address)
 West Beach Biloxi, Miss.
 sec. 35 T 2 R 10 S W
 (distance) (direction) (nearest town)


description of formations encountered	from	to
sand	0	56
clay	56	68
sand	68	84
clay + sand streaks	84	126
clay	126	199
sand	199	208
fine sand	208	228
medium sand	228	249
good sand	249	265
clay	265	269
clay + sand streaks	269	290
fine sand	290	311
clay + sand streaks	311	396
clay	396	416
clay + sand streaks	416	438
fine sand	438	456
sand	456	466
fine clay	466	476
clay	476	490
sand	490	496
clay + sand streaks	496	517
clay	517	553
sand	553	563
clay	563	579
good sand	579	643
sand	643	645
clay	645	653
sand	653	673
good sand	673	746
fine sand	746	754

WELL PURPOSE: MOTEL
 (home, irrigation, municipal, industrial)

WELL COMPLETION DATA:

(1) diameter (inches) 8 x 6
 (2) total depth (feet) 754
 (3) static water level (feet) 25 below top of ground.
 (4) casing gal. steel 694' (material) (depth) 8 x 6 (size) if telescope see back.
 (5) screen 60' (length) 694' (depth to top) 10 ga. 55 on pipe (size) (material)
 (6) pump 20 (HP) 250 (yield gpm) electric (type power)
 (7) electric log No (yes or no)
 (organization running log)
 (8) how well bottom plugged Back pressure valve


WELL COMPLETION DATA:	from	to
(1) diameter (inches)	396	416
(2) total depth (feet)	416	438
(3) static water level (feet)	438	456
(4) casing (material) (depth)	456	466
(5) screen (length) (depth to top)	466	476
(6) pump (HP) (yield gpm)	476	490
(7) electric log	490	496
(8) how well bottom plugged	496	517
	517	553
	553	563
	563	579
	579	643
	643	645
	645	653
	653	673
	673	746
	746	754

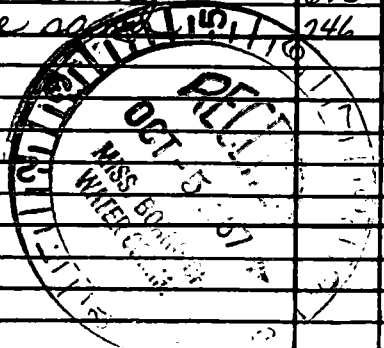

DRILLERS REMARKS:

If well telescopes please sketch and show depths.

GROUND LEVEL

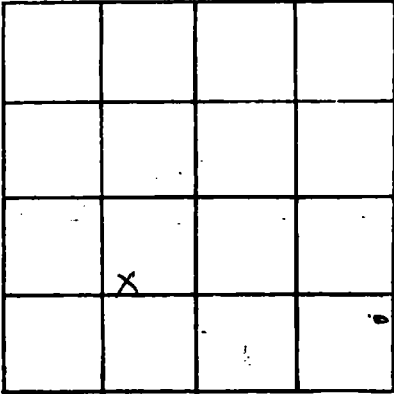

SECTION 85

Please indicate well location X.

ADDITIONAL INFORMATION

If more than one screen, show locations of each on sketch.