

Harrison  
 m 152  
 8-67

MISSISSIPPI  
 BOARD OF WATER COMMISSIONERS  
 416 North State Street  
 Jackson, Mississippi 39201

**CODED**

WATER WELL DRILLERS LOG

8/4 1967 Sutter Well Works Harrison  
 date well completed firm name county well located

LANDOWNER: Miss. City Water Co  
 Mississippi City  
 Miss.  
 (mailing address)

WELL LOCATION:  
 sec. T N 29 7 10  
 S R E W  
 miles N Miss City  
 (distance) (direction) (nearest town)


WELL PURPOSE: municipal  
 (home, irrigation, municipal, industrial)

WELL COMPLETION DATA:

- (1) diameter (inches) 4x6
- (2) total depth (feet) 799
- (3) static water level (feet) 14 below top of ground.
- (4) casing bell steel 779' (material) (depth)  
 TOP 106' of 6" Bal. 4" if telescope see back. (size)
- (5) screen 20' 779' (length) (depth to top)  
 4" Stainless Steel (size) (material)
- (6) pump 10 120 (HP) (yield gpm)  
 elec (type power)
- (7) electric log no (yes or no)  
 (organization running log)
- (8) how well bottom plugged BPU value

description of formations encountered	from to	
sand	0	34
clay	34	64
sand	64	76
clay	76	130
sand	130	182
clay	182	460
sand	460	470
clay	470	500
sand	500	530
clay	530	555
sand	555	620
clay	620	737
sand	737	804

**CODED**

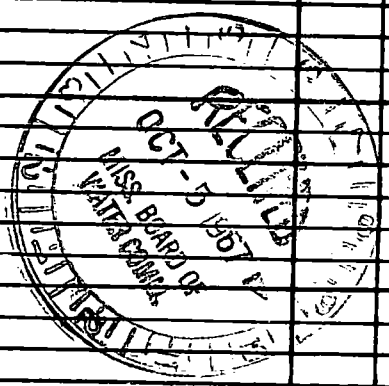

DRILLERS REMARKS:

If well telescopes please sketch and show depths.

GROUND LEVEL


SECTION \_\_\_\_\_

Please indicate well location X.

ADDITIONAL INFORMATION

If more than one screen, show locations of each on sketch.