

HARR.

MISSISSIPPI BOARD OF WATER COMMISSIONERS

M 156

4-23-62

WATER WELL DRILLERS LOG

CODED

Date: April 23 1962, Driller: L. L. Garland County Jackson (Name)

(1) Owner of Land:	Description & Color of Materials Sand, Clay, Red Clay, Shell, etc.	Thick- ness Feet	Depth Feet
Irvin Henning (Name) Biloxi Miss. (Address)	1-10' Clay 11' Sand		
	2-7' Sand 14' Mud		
	3- Mixed 21'		
	4- Mixed 21'		
	5- 21' Mud		
	6- "		
	7- 21' Mud & Sand		
	8- 10' F. Sand 11' Mud		
	9- 21' Mud		
	10- 16' Sand (Good)		

(2) Location: 1/4, 1/4, Sec. 12 T1 R10
3 miles NW of D'Arberville
(distance) (direction) (Nearest Town)

(3) Topography: (Hilly) (Flat) (Level)

(4) Purpose of Well: Domestic
(Domestic Irrigation, Municipal, Industrial, Other)

Information upon completion of well:

(1) Diameter 2 inches.

(2) Total Depth 205 feet.

(3) Water Level 10 feet below top of ground.

(4) Cased to _____, Size _____

(5) Screen: Size .08, Length 10'


(6) Were any formations sealed against pollution?
_____ yes, _____ no.

If YES depth of formation _____

Why _____

Drillers Remarks: _____

CODED

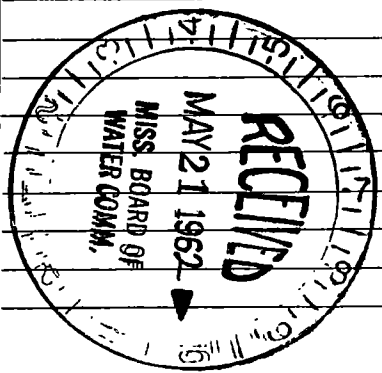

(Use Back Side)

Well No.

Handwritten notes, possibly bleed-through from the reverse side of the page. The text is mostly illegible due to the high contrast and noise of the scan.

of
1000

to