

M 140

5-20-62


WATER WELL DRILLERS LOG

CODED

Date: May 20, 1962, Driller: L. L. Harland County Harrison
 (Name)

(1) Owner of Land:	Description & Color of Materials Sand, Clay, Red Clay, Shell, etc.	Thick- ness Feet	Depth Feet
<u>F. A. Husley</u> <small>(Name)</small> <u>Rt. 1 Biloxi, Miss.</u> <small>(Address)</small>	1- 14' Clay 7' Sand		
(2) Location: _____ 1/4, _____ 1/4, Sec. <u>5 75.9</u>	2- Sand		
_____ miles _____, of _____ <small>(distance) (direction) (Nearest Town)</small>	3- 15' Sand 6' Mud		
(3) Topography: _____ <small>(Hilly) (Flat) (Level)</small>	4- Mud		
(4) Purpose of Well: <u>Dom.</u> <small>(Domestic Irrigation Municipal, Industrial, Other)</small>	5- "		
Information upon completion of well:	6- "		
(1) Diameter <u>2</u> inches.	7- "		
(2) Total Depth <u>305</u> feet.	8- "		
(3) Water Level <u>3'</u> feet below top of ground.	9- "		
(4) Cased to _____, Size _____	10- "		
(5) Screen: Size <u>.08</u> , Length <u>10'</u>	11- "		
(6) Were any formations sealed against pollution? _____ yes, <input checked="" type="checkbox"/> no.	12- "		
If YES depth of formation _____	13- "		
Why _____	14- 13' Mud 8' Sand		
Drillers Remarks: _____	15- 10' Sand (Good)		

CODED

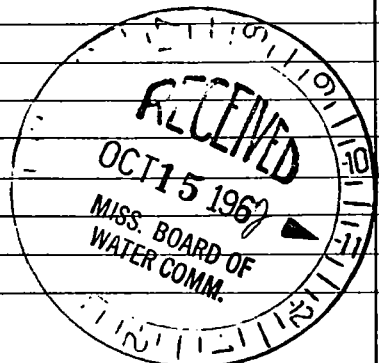

(Use Back Side)

Well No.

