

HAR.

MISSISSIPPI BOARD OF WATER COMMISSIONERS

M-1624

9-12-62

WATER WELL DRILLERS LOG

**CODED**

M<sup>27</sup>

Date: 9-12, 1962, Driller: Sutter Well Works County Harrison

(Name)

(1) Owner of Land: <u>Miss. City Water Co.</u> (Name)	Description & Color of Materials Sand, Clay, Red Clay, Shell, etc.	Thick- ness Feet	Depth Feet
<u>Miss City</u> (Address)	<u>Sand</u>	<u>48</u>	<u>48</u>
	<u>Clay</u>	<u>97</u>	<u>145</u>
(2) Location: <u>SW 1/4, NW 1/4, Sec. 30 T. 18 N. R. 10 W</u> <u>1 1/2</u> miles <u>1 N</u> of <u>Hondalava</u> (distance) (direction) (Nearest Town)	<u>Sand</u>	<u>22</u>	<u>167</u>
	<u>Clay</u>	<u>453</u>	<u>620</u>
	<u>Sand</u>	<u>38</u>	<u>658</u>
(3) Topography: <u>flat</u> (Hilly) (Flat) (Level)	<u>Clay</u>	<u>82</u>	<u>740</u>
	<u>Sand</u>	<u>62</u>	<u>802</u>
(4) Purpose of Well: <u>Municipal</u> (Domestic Irrigation Municipal, Industrial, Other)			

Information upon completion of well:

- (1) Diameter 4x6 inches.
- (2) Total Depth 802 feet.
- (3) Water Level 18 feet below top of ground.
- (4) Cased to all, Size 4" Top 100' - 6"
- (5) Screen: Size 4", Length 30'
- (6) Were any formations sealed against pollution?


yes,  no.

If YES depth of formation 15 feet

Why required

Drillers Remarks:

**CODED**

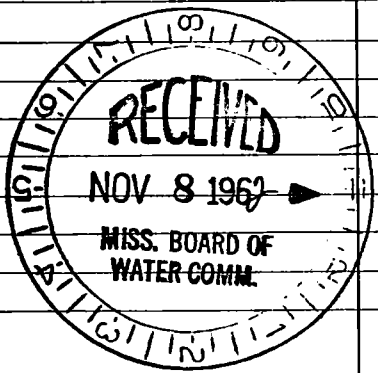

(Use Back Side)

Well No.



Handwritten text at the top center, possibly a title or header.

Handwritten text at the top right, possibly a date or reference number.

Vertical handwritten text on the left side of the page.

Vertical handwritten text in the middle-left section.

Horizontal handwritten text in the upper middle section.

Horizontal handwritten text in the middle section.

Horizontal handwritten text in the middle section.

Horizontal handwritten text in the lower middle section.

Horizontal handwritten text in the lower middle section.

Horizontal handwritten text in the lower middle section.

Horizontal handwritten text in the lower middle section.

Large handwritten text at the bottom of the page, possibly a signature or conclusion.