

HAR. MISSISSIPPI BOARD OF WATER COMMISSIONERS

M 165

9-31-62

WATER WELL DRILLERS

CODED


Harrison
~~Garland~~

Date: Sept. 31, 1962, Driller: L. L. Garland County: Harrison

(Name)

(1) Owner of Land:	Description & Color of Materials Sand, Clay, Red Clay, Shell, etc.	Thick- ness Feet	Depth Feet
<u>Mr. A. Bear</u> (Name)			
<u>Broodie Rd. Biloxi, Miss.</u> (Address)	1 Clay		
(2) Location: <u>1/4, 1/4, Sec 23 T2 R9,</u> <u>2 miles North W. of D'Arville</u> (distance) (direction) (Nearest Town)	2 mud 3 " 4 11' Mud 10' Sand 5 Mixed		
(3) Topography: _____ (Hilly) (Flat) (Level)	6 mud		
(4) Purpose of Well: <u>Domestic</u> (Domestic Irrigation Municipal, Industrial, Other)	7 " 8 " 9 "		
Information upon completion of well:	10 " 11 "		
(1) Diameter <u>2</u> inches.	12 " 13 "		
(2) Total Depth <u>385</u> feet.	14 mixed		
(3) Water Level <u>4 1/2</u> feet below top of ground.	15 shale 16 mud		
(4) Cased to _____, Size _____	17 11' Mud 10' sand 18 Sand		
(5) Screen: Size <u>.08</u> , Length <u>10</u>	19 7' sand		
(6) Were any formations sealed against pollution? _____ yes, _____ no.			
If YES depth of formation _____			
Why _____			
Drillers Remarks: _____			

CODED

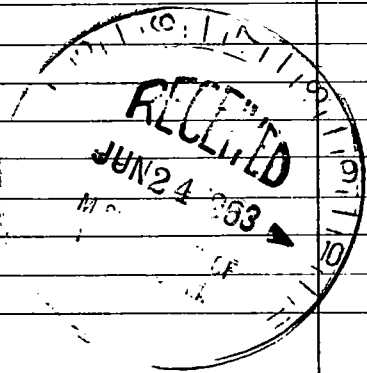

(Use Back Side)

Well No.

1900