

HAR. MISSISSIPPI BOARD OF WATER COMMISSIONERS

M 167

11-19-62

WATER WELL DRILLERS LOG

CODED

Date: Nov. 19, 1962, Driller: L. L. Garland County Warrison
(Name)

(1) Owner of Land	Description & Color of Materials Sand, Clay, Red Clay, Shell, etc.	Thick- ness Feet	Depth Feet
<u>Golden Rousseau</u> (Name) <u>North Biloxi, Miss.</u> (Address)	1 Clay		
(2) Location: <u>1/4</u> , <u>1/4</u> , Sec. <u>23 T³R⁹W</u> _____ miles _____ of _____ (distance) (direction) (Nearest Town)	2 17' 5' Mud		
(3) Topography: _____ (Hilly) (Flat) (Level)	3 Mix.		
(4) Purpose of Well: <u>Dom.</u> (Domestic Irrigation Municipal, Industrial, Other)	4 "		
	5 Mud		
	6 Mix.		
	7 11' Sand 10' Mud		
	8 Mud		
	9 "		
	10 Mix.		
	11 Mud		
	12 Mud Rock Sand		
	13 15' Mix. 6' Sand		
	14 9' Sand		


Information upon completion of well:

- (1) Diameter 2 inches.
- (2) Total Depth 282 feet.
- (3) Water Level 9 feet below top of ground.
- (4) Cased to _____, Size _____.
- (5) Screen: Size .08, Length 10'.
- (6) Were any formations sealed against pollution?
_____ yes, _____ no.

If YES depth of formation _____
Why _____

Drillers Remarks: _____

CODED

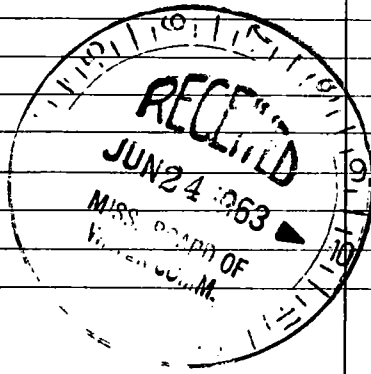

(Use Back Side)

Well No.

