

HAR.

MISSISSIPPI BOARD OF WATER COMMISSIONERS

M 170

2-26-63

WATER WELL DRILLERS LOG

CODED

Date: Feb 26, 1963, Driller: H. A. Richards County Harrison (Name)

(1) Owner of Land: H. A. Richards (Name)

Lorraine Miss. (Address)

(2) Location: 1/4, 1/4, Sec. 2 T25R10W

3 miles west of Woodmarket (distance) (direction) (Nearest Town)

(3) Topography: Hilly (Hilly) (Flat) (Level)

(4) Purpose of Well: Domestic (Domestic Irrigation Municipal, Industrial, Other)

Description & Color of Materials Sand, Clay, Red Clay, Shell, etc. Thickness Feet Depth Feet

Red sand + Clay 60 Blue clay + shells 410

CODED

Information upon completion of well:

(1) Diameter 1 1/4 inches.

(2) Total Depth 510 feet.

(3) Water Level flowing feet below top of ground.

(4) Cased to 60, Size 2 inch


(5) Screen: Size 1 1/4, Length 20 feet

(6) Were any formations sealed against pollution? yes, no.

If YES depth of formation 2 feet

Why sand

Drillers Remarks:

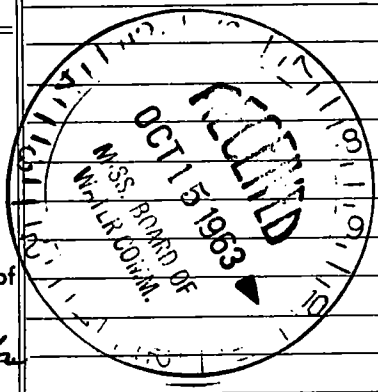

(Use Back Side)

Well No.

11 2 11

11 2 11

11 2 11

