

HAR.

M 171
3-8-63

WATER WELL DRILLERS LOG

CODED

M

Date: 3-8, 1963, Driller: Sutter Well Drilling Co. Harrison
(Name)

(1) Owner of Land: E. L. Kennedy
(Name)
Pt. 1 Biloxi, Miss.
(Address)

(2) Location: NE 1/4, NW 1/4, Sec. 22 T8R10 W
5 miles NW, of Biloxi
(distance) (direction) (Nearest Town)

(3) Topography: flat
(Hilly) (Flat) (Level)

(4) Purpose of Well: domestic
(Domestic Irrigation
Municipal, Industrial, Other)

Description & Color of Materials Sand, Clay, Red Clay, Shell, etc.	Thick- ness Feet	Depth Feet
Clay	40	40
sand	25	65
clay	90	155
sand	28	183
clay	137	320
sand	35	355
clay	100	455
sand	91	546

Information upon completion of well:

(1) Diameter 2 inches.

(2) Total Depth 546 feet.

(3) Water Level 1 feet below top of ground.

(4) Cased to all, Size 2"

(5) Screen: Size 2", Length 16'


(6) Were any formations sealed against pollution?
yes, no.

CODED

If YES depth of formation _____

Why _____

Drillers Remarks: _____

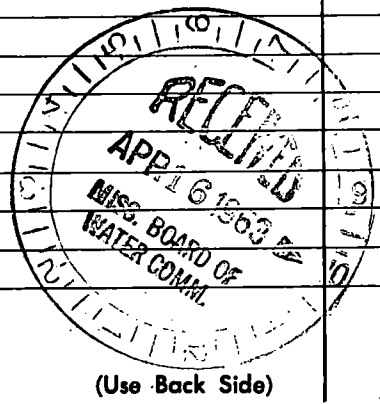

(Use Back Side)

Well No.

1941
1942
1943
2025