

M172

3-21-63

WATER WELL DRILLERS LOG

CODED

Date: March 21 1963, Driller: H.H. Ladner County Harrison
(Name)

(1) Owner of Land: Jesse Hudson
(Name)

Lorraine Road
(Address)

Description & Color of Materials
Sand, Clay, Red Clay, Shell, etc.

Thick-ness Feet

Depth Feet

sand 200
Blue Clay 111

(2) Location: 1/4, 1/4, Sec. 2 TBR/DW

3 miles West of Woodmarket
(distance) (direction) (Nearest Town)

(3) Topography: Hilly
(Hilly) (Flat) (Level)

(4) Purpose of Well: Domestic
(Domestic Irrigation
Municipal, Industrial, Other)

CODED

Information upon completion of well:

(1) Diameter 1 1/4 inches.

(2) Total Depth 306 feet.

(3) Water Level: flowing feet below top of ground.

(4) Cased to 40, Size 2 inch

(5) Screen: Size 1 1/4, Length 15.


(6) Were any formations sealed against pollution?

yes, no.

If YES depth of formation 20 feet

Why white sand

Drillers Remarks:

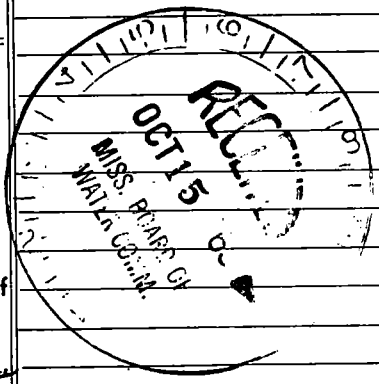

(Use Back Side)

Well No.

1871

London

1871

1871

London

1871

London

