

M175

7-16-63

WATER WELL DRILLERS LOG

CODED

Date: 7-16, 1963, Driller: Sutton Well Works County Harrison

(Name)

(1) Owner of Land: E. O. Fortenberry
 (Name)
Reynoir St. Bilopi
 (Address)

(2) Location: NE 1/4, SW 1/4, Sec. 9 T3R9C4
2 miles N, of Bilopi,
 (distance) (direction) (Nearest Town)

(3) Topography: Hilly
 (Hilly) (Flat) (Level)

(4) Purpose of Well: domestic
 (Domestic Irrigation
 Municipal, Industrial, Other)

Description & Color of Materials Sand, Clay, Red Clay, Shell, etc.	Thick- ness Feet	Depth Feet
Clay - sand streaks	55	55
sand	17	72
Clay - sand streaks	257	329
sand	41	370


CODED

Information upon completion of well:

- (1) Diameter 2 x 4 inches.
- (2) Total Depth 370 feet.
- (3) Water Level 35 feet below top of ground.
- (4) Cased to all, Size 2"
Top 105' of 4"
- (5) Screen: Size 2", Length 20'
- (6) Were any formations sealed against pollution?
no.

If YES depth of formation _____
 Why _____

Drillers Remarks: _____

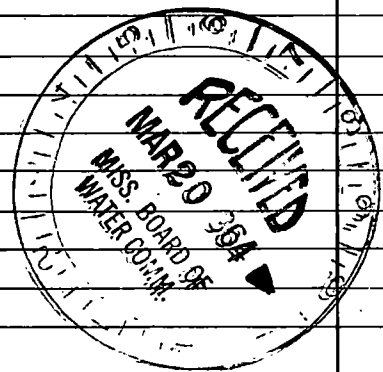

(Use Back Side)

Well No.

