

HAR.

M 176

WATER WELL DRILLERS LOG

CODED

2-20-64

Date: 2-20, 1964, Driller: Sutter Well Works County Harrison

(Name)

(1) Owner of Land: Mark Smith Jr. (Name)

4500 Elyian Fields, N.O., La. (Address)

(2) Location: NE 1/4, SW 1/4, Sec. 32 T7S R10, W

1 miles E of Murreport (distance) (direction) (Nearest Town)

(3) Topography: flat (Hilly) (Flat) (Level)

(4) Purpose of Well: Commercial (Domestic Irrigation Municipal, Industrial, Other)

Description & Color of Materials Sand, Clay, Red Clay, Shell, etc.	Thick- ness Feet	Depth Feet
Sand	31	31
Clay	12	43
Sand	32	75
Clay	215	290
Sand	65	355
Clay	44	399
Sand	31	430
Clay	32	462
Sand	21	483
Clay	84	567
Sand	52	619
Clay	11	630
Sand streaks	84	714
Sand	84	798
Clay	23	821
Sand	47	868

Information upon completion of well:

(1) Diameter 4 inches.

(2) Total Depth 868 feet.

(3) Water Level 8 feet above ground.

(4) Cased to all, Size 4"

(5) Screen: Size 2 1/2, Length 20'

(6) Were any formations sealed against pollution?


yes, no.

If YES depth of formation

Why

Drillers Remarks:

CODED

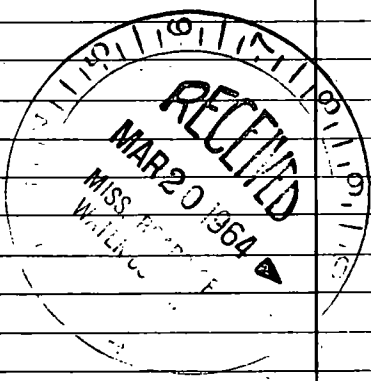

(Use Back Side)

Well No.

