

M 177
9-22-64

WATER WELL DRILLERS LOG

CODED

Date: Sept 22, 1964, Driller: Ma B Arilling Co County Harrison
(Name)

(1) Owner of Land: C. M. Plummer
(Name)
Bayou View, Crestmont, Miss.
(Address)

(2) Location: N 1/4, E 1/4, Sec. 4, T5 R10W
3/7 miles South, of Woodmark
(distance) (direction) (Nearest Town)

(3) Topography: Flat
(Hilly) (Flat) (Level)

(4) Purpose of Well: Domestic
(Domestic Irrigation
Municipal, Industrial, Other)

Description & Color of Materials Sand, Clay, Red Clay, Shell, etc.	Thick- ness Feet	Depth Feet
Clay	14	14
Sand	4	18
Red Clay	8	26
White Clay	10	36
White Sand	2	38
White Clay	4	42
Blue Clay	8	50
Sand & Clay Breaks	30	80
Blue Clay	15	95
Grey Sand (Fine)	20	115
Sand & Clay Blue	10	125
Sand & Clay Breaks	10	135
Blue Clay	30	165
Grey Sand	2	167
Blue Clay	46	213
Grey Sand	2	215
Blue Clay	2	217
Grey Sand	8	225
Blue Clay	10	235
Grey Sand	27	262

Information upon completion of well:

(1) Diameter: 8 1/4 Top 3" x 2" Below inches.

(2) Total Depth: 262 feet.

(3) Water Level: 34 feet below top of ground.

(4) Cased to: 252, Size 3" x 2"

(5) Screen: Size 2" x 1/4", Length 10 ft.


(6) Were any formations sealed against pollution?
_____ yes, _____ no.

If YES depth of formation _____

Why _____

Drillers Remarks: _____

CODED

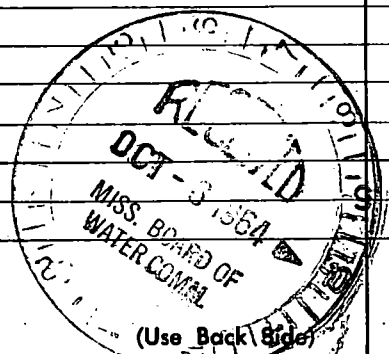

Well No. _____

