

Harrison

M 180

5-66

MISSISSIPPI BOARD OF WATER COMMISSIONERS

WATER WELL DRILLERS LOG

CODED

Date: 5-27, 1966, Driller: C.T. Switzer Well Co. County Harrison

(1) Owner of Land: Joe Juon
Camp Wilkes Rd - Biloxi
(2) Location: SW 1/4, NE 1/4, Sec. 14 T7 R10
(3) Topography: X
(4) Purpose of Well: Domestic


Table with 3 columns: Description & Color of Materials, Thickness Foot, Depth Foot. Rows include clay, sand, clay, sand, clay, sand, fine, clay, sand.

Information upon completion of well:

(1) Diameter 2 inches.
(2) Total Depth 373 feet.
(3) Water Level 22' feet below top of ground.
(4) Cased to 373', Size 2"
(5) Screen: Size 8 ga SS, Length 10'
(6) Were any formations sealed against pollution? X yes, no.

CODED

If YES depth of formation
Why Health Dept. Arguments.
Drillers Remarks:
Yield in gpm:
Size pump:
Type power:

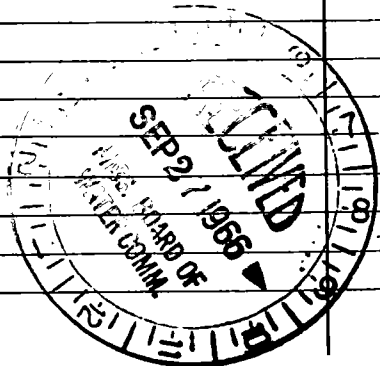

1944

1944-1945

1944-1945

