

HARRISON

M 182

MSGW 14755

MISSISSIPPI BOARD OF WATER COMMISSIONERS

5-17-66

WATER WELL DRILLERS LOG

CODED

Date: 5-17, 1966, Driller: C.T. Switzer Well Co. County Harrison

(When well drilled)

(Name)

(Where well is located)


Treasure Bay Casino  
 (1) Owner of Land: John Mladinich  
 (Name)  
 W. Beach Highway 90 - Biloxi, Miss.  
 (Address)  
 (2) Location: 1/4, 1/4, Sec. 35 T7S R10W  
 miles of  
 (distance) (direction) (Nearest Town)  
 (3) Topography: X  
 (Hilly) (Flat) (Level)  
 (4) Purpose of Well: Domestic Comm  
 (Domestic Irrigation  
 Municipal, Industrial, Other)

Description & Color of Materials Sand, Clay, Red Clay, Shell, etc.	Thick- ness Feet	Depth Feet
sand	0	21
course brown sand	21	24
sand	24	38
soft clay	38	90
clay w sand	90	100
clay	100	154
fine sand	154	172
sand	172	175
clay	175	204
sand	204	214
clay	214	215
clay	215	366
fine sand	366	379
clay	379	386
clay and shale	386	407
Fullers Earth and clay	407	453
fine sand	453	477
hard clay	477	479
clay	479	541
clay, Fullers earth	541	584
clay	584	614
sand	614	649
sand, good	649	702
gravel	702	716

CODED

Information upon completion of well:

(1) Diameter 8x6 inches.  
 (2) Total Depth 716 feet.  
 (3) Water Level 19' feet below top of ground.  
 (4) Cased to 716', Size 8x6 top 93'-8"  
 (5) Screen: Size 1/2" SS, Length 50'  
 (6) Were any formations sealed against pollution?  
 X yes, no.  
 If YES depth of formation \_\_\_\_\_  
 Why Health Dept. Elements.  
 Drillers Remarks:  
 Yield in gpm:  
 Size pump:  
 Type power:

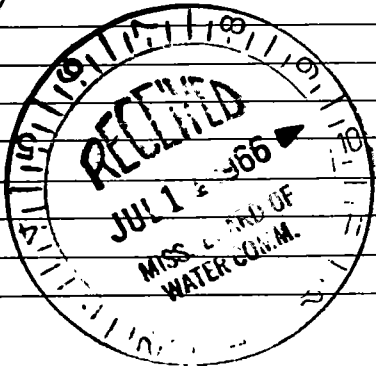

SECRET

(S)

(S)

