

**CODED**

**WATER WELL DRILLERS LOG**

Date: July 6, 1966, Driller: Harb Swilling Co County Harrison  
(When well drilled) (Name) (Where well is located)

1) Owner of Land: Forrest Cove Estate  
(Name)  
A.H. Gay - Brodie, Md.  
(Address) North Nashville, Miss.  
 2) Location: 1/4, SW 1/4, Sec. 17 T5R9W  
1 1/2 miles West of Nashville  
(distance) (direction) (Nearest Town)  
 3) Topography: Flat  
(Hilly) (Flat) (Level)  
 4) Purpose of Well: Subirrigation  
(Domestic Irrigation) (Municipal, Industrial, Other)


Description & Color of Materials Sand, Clay, Red Clay, Shell, etc.	Thick- ness Feet	Depth Feet
Surface	10	10
White Sand or Gravel	10	20
Grey Clay	30	50
Old Swamp	20	70
Blue Clay	20	90
Fine Sand	10	100
Blue Clay	100	200
Fine Sand	8	208
Blue Clay	24	232
Fine Sand	7	239
Blue Clay	6	245
Sand - Fine	37	282
Blue Clay	53	335
Coarse Grey Sand	35	370
Blue Clay		

Information upon completion of well:

1) Diameter 4 inches.  
 2) Total Depth 370 feet.  
 3) Water Level 20 feet below top of ground.  
 4) Cased to 350 FT, Size \_\_\_\_\_  
 5) Screen: Size 3", Length 20 FT  
# 8 slot  
 6) Were any formations sealed against pollution?  
 \_\_\_\_\_ yes, \_\_\_\_\_ no.

**CODED**

YES depth of formation \_\_\_\_\_  
 Why \_\_\_\_\_  
 Drillers Remarks: \_\_\_\_\_  
 Yield in gpm: 100  
 Size pump: 5 HP Submersible  
 Type power: 1 φ

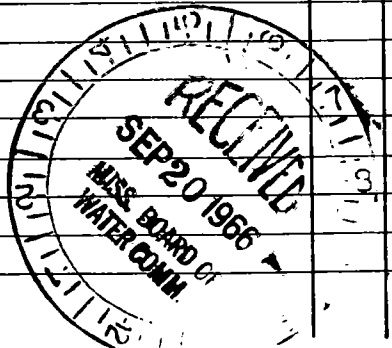



1944

...

...

Main body of faint, illegible text covering the middle section of the page.

Bottom section of faint, illegible text, possibly containing a signature or a date.