

Harrison
M192
9-66

MISSISSIPPI BOARD OF WATER COMMISSIONERS

WATER WELL DRILLERS LOG

CODED

Date: 9-23, 1966, Driller C.T. Switzer Well Co. County Harrison
(When well drilled) (Name) (Where well is located)

		Description & Color of Materials Sand, Clay, Red Clay, Shell, etc.	Thick- ness Feet	Depth Feet
(1) Owner of Land: <u>Mrs. C. L. Buchanan</u> <u>Route 3, Box 3</u> (Name) <u>Ed. 1/4 mi. N. Bayou Bernard Bridge -</u> <u>corner Thompson</u> (Address) <u>Road.</u>		<u>sandy topsoil</u>	<u>0</u>	<u>8</u>
		<u>clay</u>	<u>8</u>	<u>20</u>
		<u>yellow sand</u>	<u>20</u>	<u>22</u>
(2) Location: <u>SE 1/4, SW 1/4, Sec. 19 T7 R10</u>		<u>sand</u>	<u>22</u>	<u>43</u>
		<u>sandy clay + gravel</u>	<u>43</u>	<u>57</u>
_____ miles _____ of _____ (distance) (direction) (Nearest Town)		<u>gravel</u>	<u>57</u>	<u>92</u>
(3) Topography: _____ (Hilly) (Flat) (Level)		<u>clay</u>	<u>92</u>	<u>96</u>
(4) Purpose of Well: <u>domestic</u> (Domestic Irrigation Municipal, Industrial, Other)		<u>gravel</u>	<u>96</u>	<u>108</u>
		<u>sandy clay</u>	<u>108</u>	<u>116</u>
		<u>sand</u>	<u>116</u>	<u>124</u>
		<u>gravel</u>	<u>124</u>	<u>132</u>
		<u>clay</u>	<u>132</u>	<u>241</u>
		<u>sand streaks</u>	<u>241</u>	<u>248</u>
		<u>sand</u>	<u>248</u>	<u>292</u>

Information upon completion of well:

- (1) Diameter 2 inches.
- (2) Total Depth 292 feet.
- (3) Water Level 16 feet below top of ground.
- (4) Cased to 292', Size 2"
- (5) Screen: Size 8 ga ss, Length 10'
- (6) Were any formations sealed against pollution?
X yes, _____ no.

If YES depth of formation _____

Why Health Dept. Agments.


Drillers Remarks: _____

Yield in gpm: _____

Size pump: _____

Type power: _____

CODED

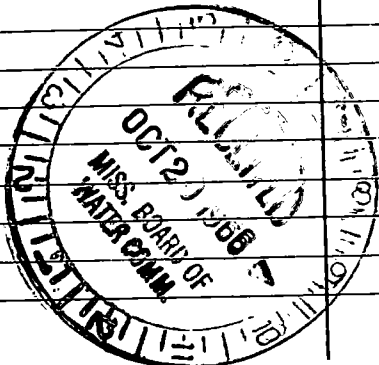

[The page contains extremely faint and illegible text, likely bleed-through from the reverse side of the document. The text is arranged in approximately 15 horizontal lines across the page.]