

Harrison
M 198
12-66
Elec Log

MISSISSIPPI
 BOARD OF WATER COMMISSIONERS
 416 North State Street
 Jackson, Mississippi 39201
WATER WELL DRILLERS LOG

CODED


12-23 1966 C.T. Switzer Well Co. Harrison
 date well completed firm name county well located

LANDOWNER: <u>Country Club</u>	description of formations encountered	from	to
<u>Dopp's Ferry Rd. Biloxi</u> (mailing address)			
WELL LOCATION:	<u>clay</u>	<u>0</u>	<u>31</u>
sec. <u>15</u> T <u>7</u> R <u>10</u>	<u>sand</u>	<u>31</u>	<u>89</u>
<u>7</u> miles <u>NW</u> of <u>Biloxi</u>	<u>mixed</u>	<u>89</u>	<u>94</u>
(distance) (direction) (nearest town)	<u>sand</u>	<u>94</u>	<u>108</u>
WELL PURPOSE: <u>irrigation</u> (home, irrigation, municipal, industrial)	<u>mixed</u>	<u>108</u>	<u>130</u>
WELL COMPLETION DATA:	<u>clay</u>	<u>130</u>	<u>316</u>
(1) diameter (inches) <u>top 102' of 8" 8" x 6"</u>	<u>sand</u>	<u>316</u>	<u>342</u>
(2) total depth (feet) <u>853</u>	<u>medium sand</u>	<u>342</u>	<u>365</u>
(3) static water level (feet) <u>7</u> above top of ground.	<u>good sand</u>	<u>365</u>	<u>376</u>
(4) casing <u>gal. steel 843'</u> (material) (depth)	<u>clay</u>	<u>376</u>	<u>414</u>
<u>8x6</u> If telescope see back. (size)	<u>sand</u>	<u>414</u>	<u>420</u>
(5) screen <u>60'</u> (length) <u>843'</u> (depth to top)	<u>clay</u>	<u>420</u>	<u>423</u>
<u>6"</u> (size) <u>stainless steel on pipe</u> (material)	<u>sand</u>	<u>423</u>	<u>433</u>
(6) pump <u>10</u> (HP) <u>250</u> (yield gpm)	<u>clay + shale</u>	<u>433</u>	<u>452</u>
<u>electric</u> (type power)	<u>clay</u>	<u>452</u>	<u>454</u>
(7) electric log <u>Yes</u> (yes or no)	<u>clay with sand streak</u>	<u>454</u>	<u>468</u>
<u>USGS</u> (organization running log)	<u>sand</u>	<u>468</u>	<u>474</u>
(8) how well bottom plugged <u>back pressure valve</u>	<u>good sand</u>	<u>474</u>	<u>538</u>
DRILLERS REMARKS:	<u>sand</u>	<u>538</u>	<u>555</u>
	<u>mixed</u>	<u>555</u>	<u>563</u>
	<u>sand</u>	<u>563</u>	<u>568</u>
	<u>clay</u>	<u>568</u>	<u>600</u>
	<u>good sand</u>	<u>600</u>	<u>606</u>
	<u>sand</u>	<u>606</u>	<u>620</u>
	<u>clay</u>	<u>620</u>	<u>627</u>
	<u>mixed</u>	<u>627</u>	<u>649</u>
	<u>clay</u>	<u>649</u>	<u>697</u>
	<u>mixed</u>	<u>697</u>	<u>718</u>
	<u>clay</u>	<u>718</u>	<u>755</u>
	<u>sand</u>	<u>755</u>	<u>760</u>
	<u>clay</u>	<u>760</u>	<u>763</u>
	<u>clay + sand</u>	<u>763</u>	<u>773</u>
	<u>clay</u>	<u>773</u>	<u>785</u>
	<u>mixed</u>	<u>785</u>	<u>790</u>
	<u>sand</u>	<u>790</u>	<u>890</u>
	<u>clay</u>	<u>890</u>	<u>893</u>

CODED

If well telescopes please sketch and show depths.

GROUND LEVEL

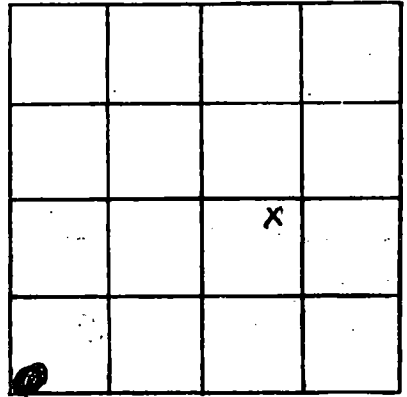

SECTION 15

Please indicate well location X.

ADDITIONAL INFORMATION

A series of horizontal lines for writing additional information, starting below the 'ADDITIONAL INFORMATION' header and extending to the bottom of the page.

If more than one screen, show locations of each on sketch.