

Harrison  
M200  
1-67

MISSISSIPPI  
BOARD OF WATER COMMISSIONERS  
416 North State Street  
Jackson, Mississippi 39201

**CODED**

WATER WELL DRILLERS LOG

1-20 1967 SUTTER WELL WORKS HARRISON  
date well completed firm name county well located

LANDOWNER: CHAS. ORR  
RT. 1 Box 113-C  
GULFPORT MISS.  
(mailing address)  
WELL LOCATION:  
sec. 7 T. 2 S. R. 10 W.  
miles IN of LORRAINE  
(distance) (direction) (nearest town)


description of formations encountered	from	to
	CLAY	0
SAND	20	35
CLAY	35	165
FINE SAND	165	190
CLAY	190	423
SAND	423	443

WELL PURPOSE: Home  
(home, irrigation, municipal, industrial)

WELL COMPLETION DATA:  
(1) diameter (inches) 2  
(2) total depth (feet) 443  
(3) static water level (feet) 6 below above-  
top of ground.  
(4) casing GALV. 433  
(material) (depth)  
(size) if telescope see back.  
(5) screen 10' 433  
(length) (depth to top)  
2" STAINLESS STEEL  
(size) (material)  
(6) pump 1/2 15  
(HP) (yield gpm)  
ELEC  
(type power)  
(7) electric log No  
(yes or no)  
(organization running log)

**CODED**

(8) how well bottom plugged B.P. VALVE

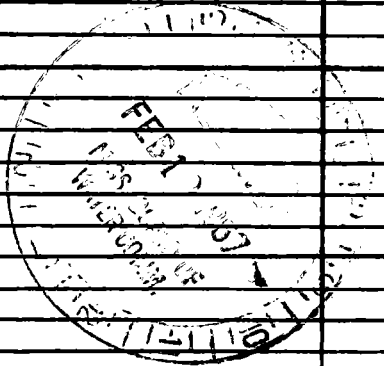

DRILLERS REMARKS:

If well telescopes please sketch and show depths.

GROUND LEVEL



X			

SECTION 7

Please indicate well location X.

ADDITIONAL INFORMATION

If more than one screen, show locations of each on sketch.