

Harrison
M204
1-67

MISSISSIPPI
BOARD OF WATER COMMISSIONERS
416 North State Street
Jackson, Mississippi 39201
WATER WELL DRILLERS LOG

CODED

1-18 1967 C.T. Switzer, Well Co. Harrison
date well completed firm name county well located

LANDOWNER James Chandler

description of formations encountered	from	to
clay	0	14
sand	14	22
clay	22	39
sand	39	48
clay	48	70
sand	70	76
clay	76	84
sandy clay	84	127
clay	127	140
fine sand	140	148
okay sand	148	162
clay	162	169
good sand	169	175
brandy clay	175	187
clay	187	212
sand streaks	212	218
sand	218	228
clay	228	238
good sand	238	249
sand	249	254
clay + sand streaks	254	260

219 Hart Ave. Biloxi, Miss.
(mailing address)

WELL LOCATION:
sec. 22 T 7 S R 9 W
1 miles N. of Biloxi
(distance) (direction) (nearest town)

WELL PURPOSE: home
(home, irrigation, municipal, industrial)

WELL COMPLETION DATA:


- (1) diameter (inches) 2
- (2) total depth (feet) 255
- (3) static water level (feet) 17 below top of ground.
- (4) casing gal. steel (material), 245' (depth)
2 (size) if telescope see back.
- (5) screen 10' (length), 245' (depth to top)
2" (size), 8 gals on pipe (material)
- (6) pump 3/4 (HP), 14 (yield gpm)
electric (type power)
- (7) electric log No (yes or no)
(organization running log)
- (8) how well bottom plugged back
pressure valve

CODED

DRILLERS REMARKS:

If well telescopes please sketch and show depths.

GROUND LEVEL

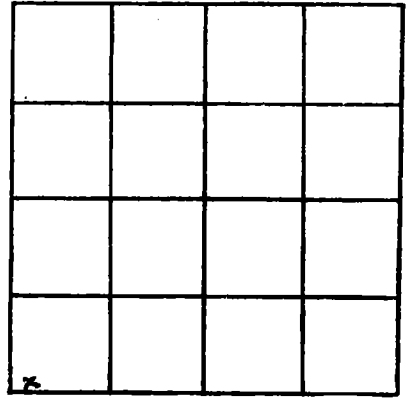

SECTION 22

Please indicate well location X.

ADDITIONAL INFORMATION

If more than one screen, show locations of each on sketch.