

Harrison
M205
1-67

MISSISSIPPI
BOARD OF WATER COMMISSIONERS
416 North State Street
Jackson, Mississippi 39201

CODED

WATER WELL DRILLERS LOG

1-24 1967 Switzer Well Co. Harrison
date well completed firm name county well located

LANDOWNER: William Forehand

description of formations encountered

from

to

Big Ridge Rd. 2 1/2 hrs. E Highway 15
Box 3, Box 321, Biloxi
(mailing address)

<u>sandy clay</u>	0	23
<u>soft clay</u>	23	44
<u>soft clay + sand streaks</u>	44	65
<u>soft clay</u>	65	86
<u>clay</u>	86	291
<u>sand</u>	291	293
<u>fine sand</u>	293	312
<u>clay</u>	312	366
<u>sand</u>	366	372
<u>good sand</u>	372	395

WELL LOCATION:

sec 9 T 7 S R 9 E W
4 miles N of Biloxi
(distance) (direction) (nearest town)

WELL PURPOSE: Home
(home, irrigation, municipal, industrial)


WELL COMPLETION DATA:

- (1) diameter (inches) 2
- (2) total depth (feet) 394
- (3) static water level (feet) 46 below top of ground.
- (4) casing gal. steel, 394'
(material) (depth)
2" if telescope see back.
(size)
- (5) screen 10', 384'
(length) (depth to top)
2", 8 ga SS on pipe
(size) (material)
- (6) pump 1/2 8.5
(HP) (yield gpm)
electric
(type power)
- (7) electric log No
(yes or no)
(organization running log)

(8) how well bottom plugged back
pressure valve


DRILLERS REMARKS:

CODED

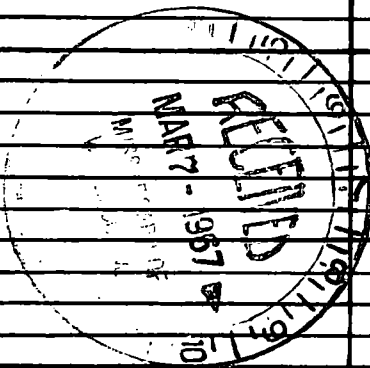

If well telescopes please sketch and show depths.

GROUND LEVEL

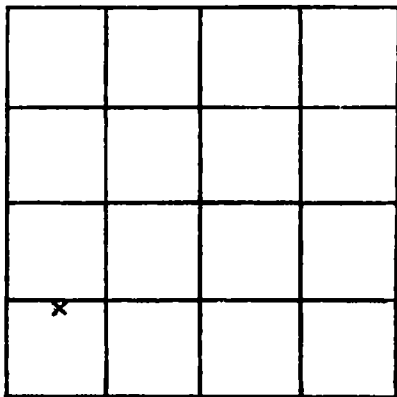

SECTION 9

Please indicate well location X.

ADDITIONAL INFORMATION

If more than one screen, show locations of each on sketch.