

MISSISSIPPI  
BOARD OF WATER COMMISSIONERS  
416 North State Street  
Jackson, Mississippi 39201

**CODED**

WATER WELL DRILLERS LOG

Harrison  
M 207  
2-67

2-3 1967 Switzer Well Co. Harrison  
date well completed firm name county well located

LANDOWNER: PURE OIL CO.

Corner Hwy 90 + Pat Harrison

(mailing address)

WELL LOCATION:

sec. 36 T. 7 S. R. 10 E. W.  
miles 1.5 (distance) of BYLUXI (direction) of (nearest town)

WELL PURPOSE:

(home, irrigation, municipal, industrial)

WELL COMPLETION DATA:

- (1) diameter (inches) 2
- (2) total depth (feet) 655
- (3) static water level (feet) 10 below top of ground.
- (4) casing gal. steel (material) 645' (depth)
- 2" (size) if telescope see back.
- (5) screen 10' (length) 645' (depth to top)
- 2" (size) 8gass on pipe (material)
- (6) pump 3/4 (HP) 14 (yield gpm)
- electric (type power)
- (7) electric log no (yes or no)

(organization running log)


- (8) how well bottom plugged back  
pressure value

description of fomations encountered

from to

sand	0	37
clay	37	41
clay + shells	41	101
sand	101	119
clay	119	195
fine sand	195	205
band	205	208
clay	208	270
fine sand	270	276
clay	276	310
mixed	310	324
clay	324	453
mixed	453	463
clay	463	509
clay + sand streaks	509	530
shale	530	608
sand	608	613
fine sand	613	623
good sand	623	655

**CODED**

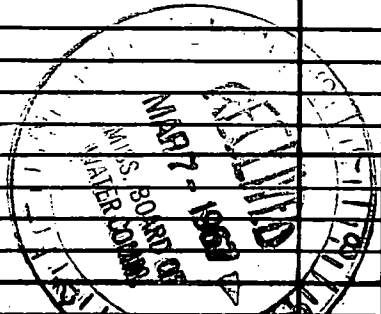

DRILLERS REMARKS:

