

**MISSISSIPPI
BOARD OF WATER COMMISSIONERS**
416 North State Street
Jackson, Mississippi 39201

CODED

WATER WELL DRILLERS LOG

Harrison
M 210
4-67

4-4 1967 Switzer Well Co. Harrison
date well completed firm name county well located

LANDOWNER: George Swan
Cedar Lake Gold around
first curve going north
P.O. Box 621 Biloxi Miss.
(mailing address)

description of formations encountered	from	to
clay	0	12
sand	12	22
sand + gravel	22	34
clay	34	44
mixed sand + gravel	44	65
clay	65	151
mixed	151	173
clay	173	296
sand	296	299
clay	299	306
gold sand	306	328
sand	321	331


WELL LOCATION:
sec 12 T. 7 S. R. 10 W.
6 miles NW of BILOXI
(distance) (direction) (nearest town)

WELL PURPOSE: Home
(home, irrigation, municipal, industrial)

WELL COMPLETION DATA:

- (1) diameter (inches) 2
- (2) total depth (feet) 330
- (3) static water level (feet) 20 below top of ground.
- (4) casing gal steel 320' (material) (depth)
2" (size) If telescope see back.
- (5) screen 8' (length) 320' (depth to top)
8 1/2" (size) SS on pipe (material)
- (6) pump 1/2 (HP) 8.5 (yield gpm)
electric (type power)
- (7) electric log NO (yes for no)
(organization running log)
- (8) how well bottom plugged back
pressure valve

CODED

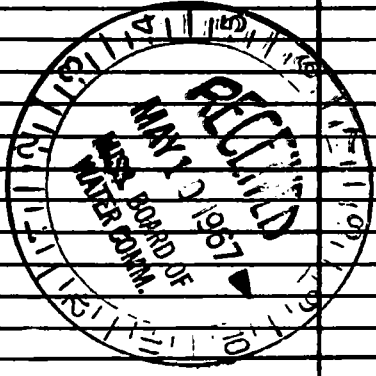

DRILLERS REMARKS:

If well telescopes please sketch and show depths.

GROUND LEVEL

			X

SECTION 12

Please indicate well location X.

ADDITIONAL INFORMATION

If more than one screen, show locations of each on sketch.