

Harrison

M 211

4-67

MISSISSIPPI
 BOARD OF WATER COMMISSIONERS
 416 North State Street
 Jackson, Mississippi 39201

CODED

WATER WELL DRILLERS LOG

4-10 1967 Switzer Shell Co. Harrison
 date well completed firm name county well located

LANDOWNERS John Niels

description of formations encountered	from	to
---------------------------------------	------	----

Deep South Motel, S. Beach
Gulfport, 1/4 mi. E. Seagarden
 (mailing address) Road

sand	0	60
clay	60	63
sand	63	71
clay	71	130
sand	130	146
clay	146	208
sand	208	214
clay	214	465
sand	465	479
clay	479	512
sand	512	546
clay	546	577
sand	577	631
clay	631	781
sand	781	886

WELL LOCATION:
 sec. 31 T. 7 S. R. 10 W.
4 miles E of GULFPORT
 (distance) (direction) (nearest town)

WELL PURPOSE: INDUSTRIAL
 (home, irrigation, municipal, industrial)

WELL COMPLETION DATA:


- (1) diameter (inches) 2x4
- (2) total depth (feet) 886
- (3) static water level (feet) 5 below top of ground.
- (4) casing gal. steel 856'
 (material) (depth)
- 3x2 if telescope see back.
 (size)
- (5) screen 30' 856'
 (length) (depth to top)
- 3x2 stainless steel
 (size) (material) on pipe
- (6) pump 1 20 GPM
 (HP) (yield gpm)
- electric
 (type power)
- (7) electric log No
 (yes or no)

(organization running log)

(8) how well bottom plugged back
pressure valve

DRILLERS REMARKS:

CODED

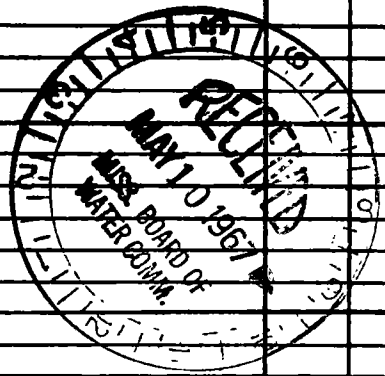

If well telescopes please sketch and show depths.

GROUND LEVEL

X			

SECTION 31

Please indicate well location X.

ADDITIONAL INFORMATION

If more than one screen, show locations of each on sketch.