

Harrison
M212
4-67

MISSISSIPPI
BOARD OF WATER COMMISSIONERS
416 North State Street
Jackson, Mississippi 39201

CODED

WATER WELL DRILLERS LOG

4-26 1967 Switzer Well Co. Harrison
date well completed firm name county well located

LANDOWNER: Benton Knopf
Whetstone Subdivision
13 Ann Court St. Biloxi
(mailing address)

description of formations encountered	from	to
sand	0	10
clay	10	23
clay + sand str.	23	44
clay	44	75
sand	75	85
clay	85	106
fine sand	106	148
fair sand	148	169
sand	169	179
clay	179	210
fine sand	210	239
clay	239	329
sand	329	333
fair sand	333	352
good sand	352	362


WELL LOCATION:
sec. 7 T. 7 S. R. 9 W.
5 miles NW of Biloxi
(distance) (direction) (nearest town)

WELL PURPOSE: Home
(home, irrigation, municipal, industrial)

WELL COMPLETION DATA:

- (1) diameter (inches) 2
- (2) total depth (feet) 361
- (3) static water level (feet) 30 below top of ground.
- (4) casing gal. steel (material) 351' (depth)
2" (size) if telescope see back.
- (5) screen 10' (length) 351' (depth to top)
8 ga. (size) SS on pipe (material)
- (6) pump Not Installed (HP) (yield gpm)
(type power)
- (7) electric log No (yes or no)
(organization running log)
- (8) how well bottom plugged back
pressure valve


CODED

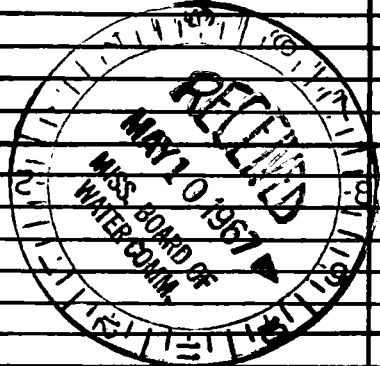

DRILLERS REMARKS:

If well telescopes please sketch and show depths.

GROUND LEVEL

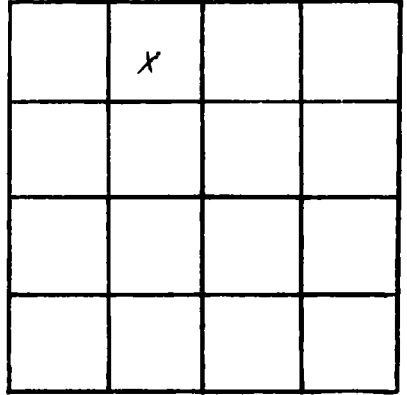

SECTION 7

Please indicate well location X.

ADDITIONAL INFORMATION

If more than one screen, show locations of each on sketch.